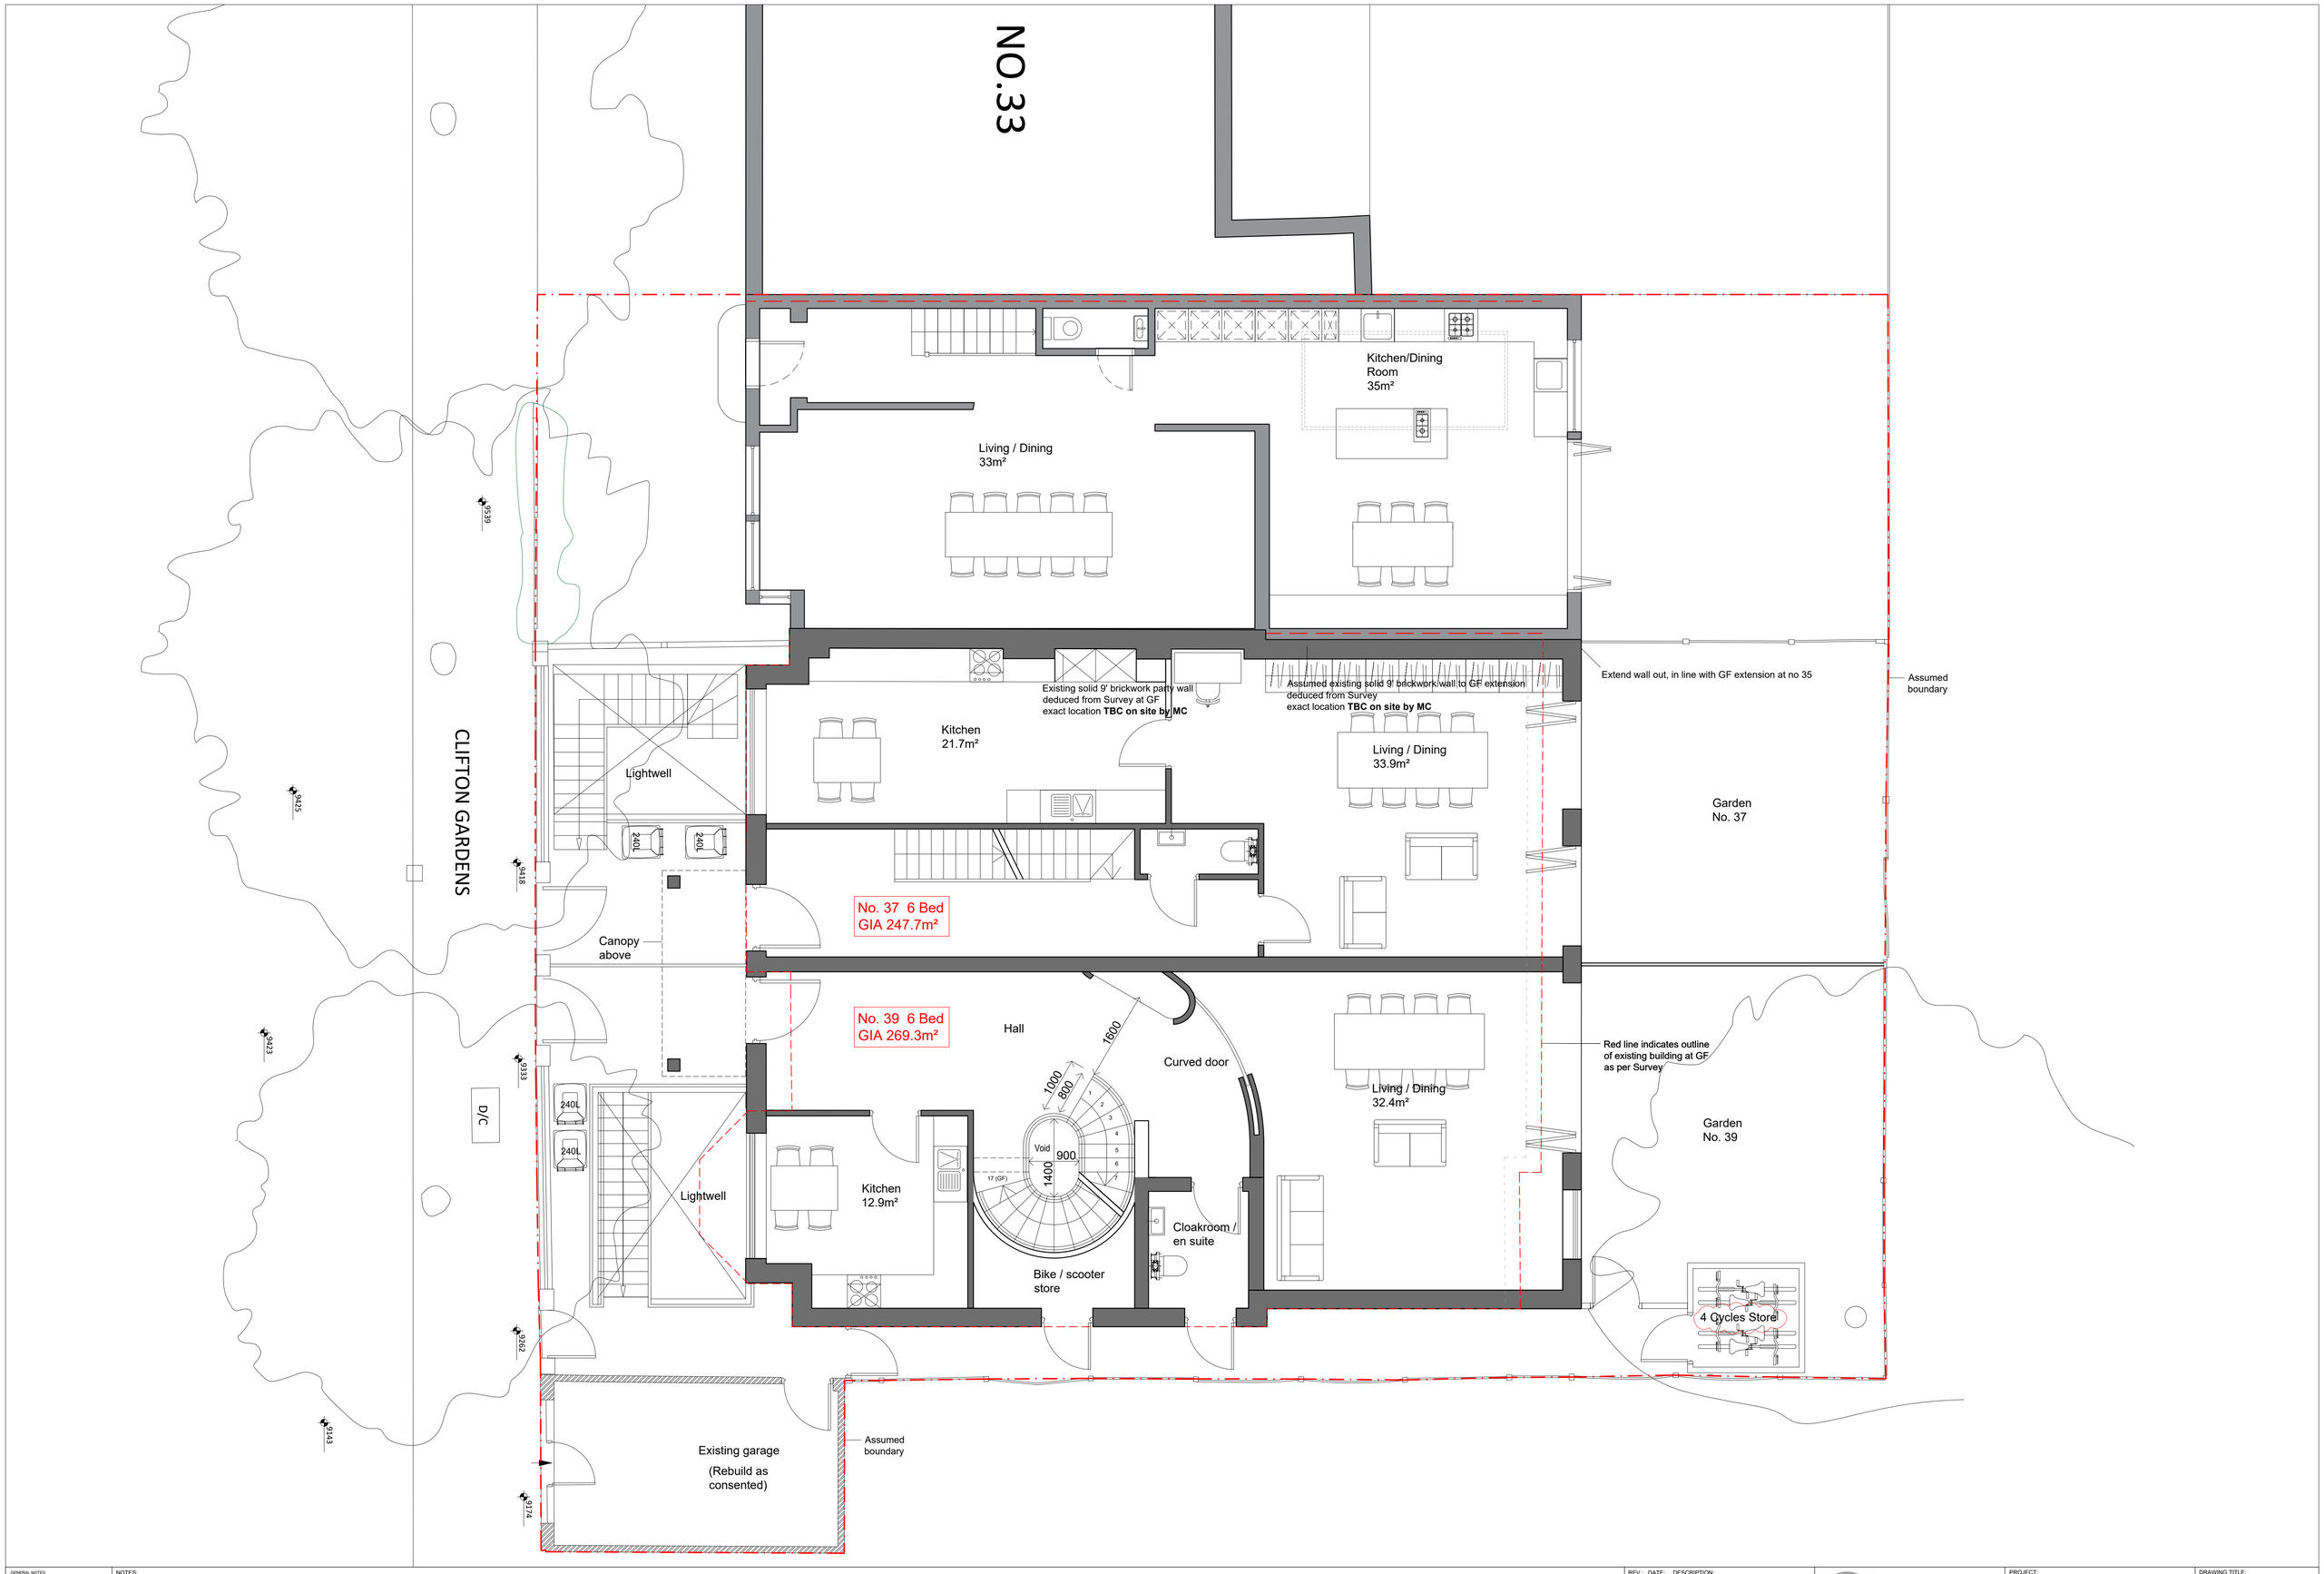

GENERAL NOTES:

USE FIGURED DIMENSIONS ONLY.
DO NOT SCALE OFF DRAWINGS.
ALL DIMENSIONS ARE TO BE CHECKED ON SITE.
INCONSISTENCIES ARE TO BE REPORTED TO
OATEN ARCHITECTS IMMEDIATELY.

COPYRIGHT OF OATEN ARCHITECTS LTD.

NOTES:

1:50
0 1 2 3 4 5

REV.: DATE: DESCRIPTION:

OATEN ARCHITECTS
Oaten Architects Ltd,
33 West Street, Hastings, East Sussex, TN34 3AN
T 01424 256476
E office@oatenarchitects.com
W www.oatenarchitects.com

PROJECT: 35-39 Clifton Gardens N15 6AP

STAGE:	SCALE:	DRAWN BY : DATE:
Planning	1:50 @ A1	CT - 11/2020
CLIENT: BMR Bagshot Ltd.	1:100@ A3	CHECKED BY: RO

DRAWING TITLE: Existing As-Built GF Plan

DRAWING NO: 20.1212 / 017 -

REV NO: -

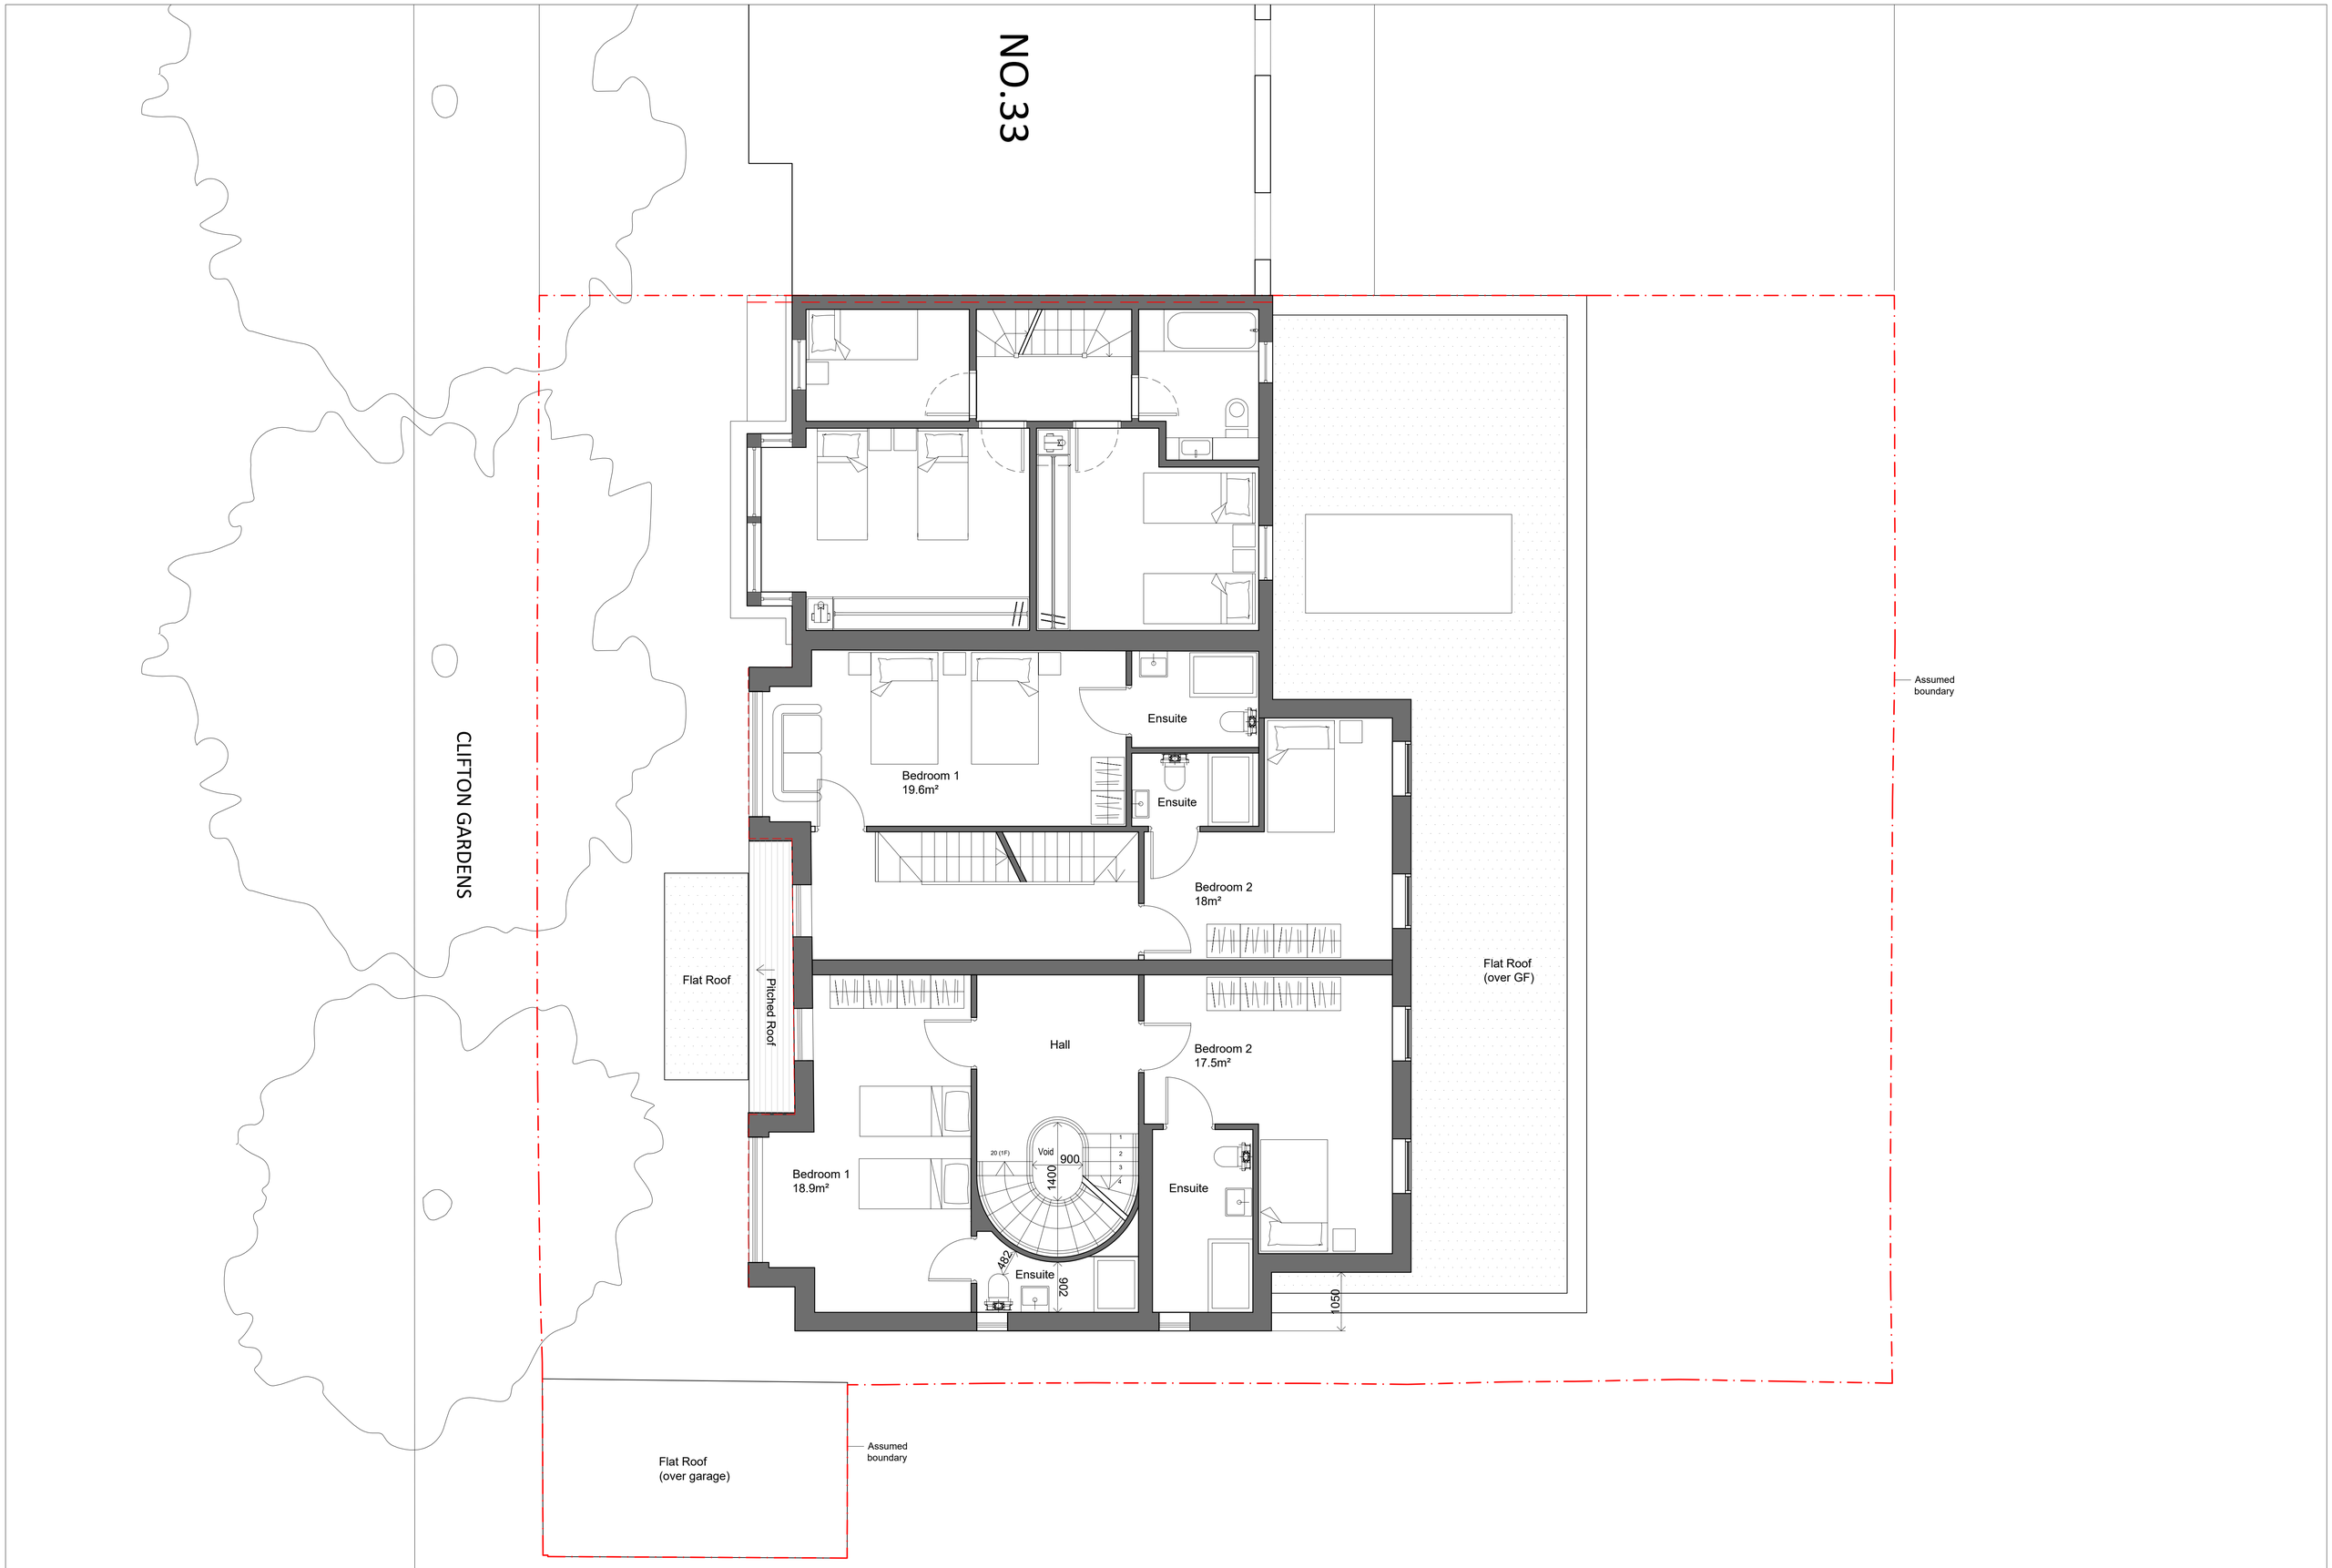

GENERAL NOTES:

USE FIGURED DIMENSIONS ONLY.
DO NOT SCALE OFF DRAWINGS.
ALL DIMENSIONS ARE TO BE CHECKED ON SITE.
INCONSISTENCIES ARE TO BE REPORTED TO OATEN ARCHITECTS IMMEDIATELY.

COPYRIGHT OF OATEN ARCHITECTS LTD.

NOTES:

1:50
0 1 2 3 4 5

REV.: DATE: DESCRIPTION:

OATEN ARCHITECTS
Oaten Architects Ltd,
33 West Street, Hastings, East Sussex, TN34 3AN
T 01424 256476
E office@oatenarchitects.com
W www.oatenarchitects.com

PROJECT: 35-39 Clifton Gardens N15 6AP

STAGE:	SCALE:	DRAWN BY : DATE:
Planning	1:50 @ A1	CT - 11/2020
CLIENT: BMR Bagshot Ltd.	1:100@ A3	CHECKED BY: RO

DRAWING TITLE: Existing as-built 1F Plan

DRAWING NO: 20.1212 / 018 -

REV NO: -

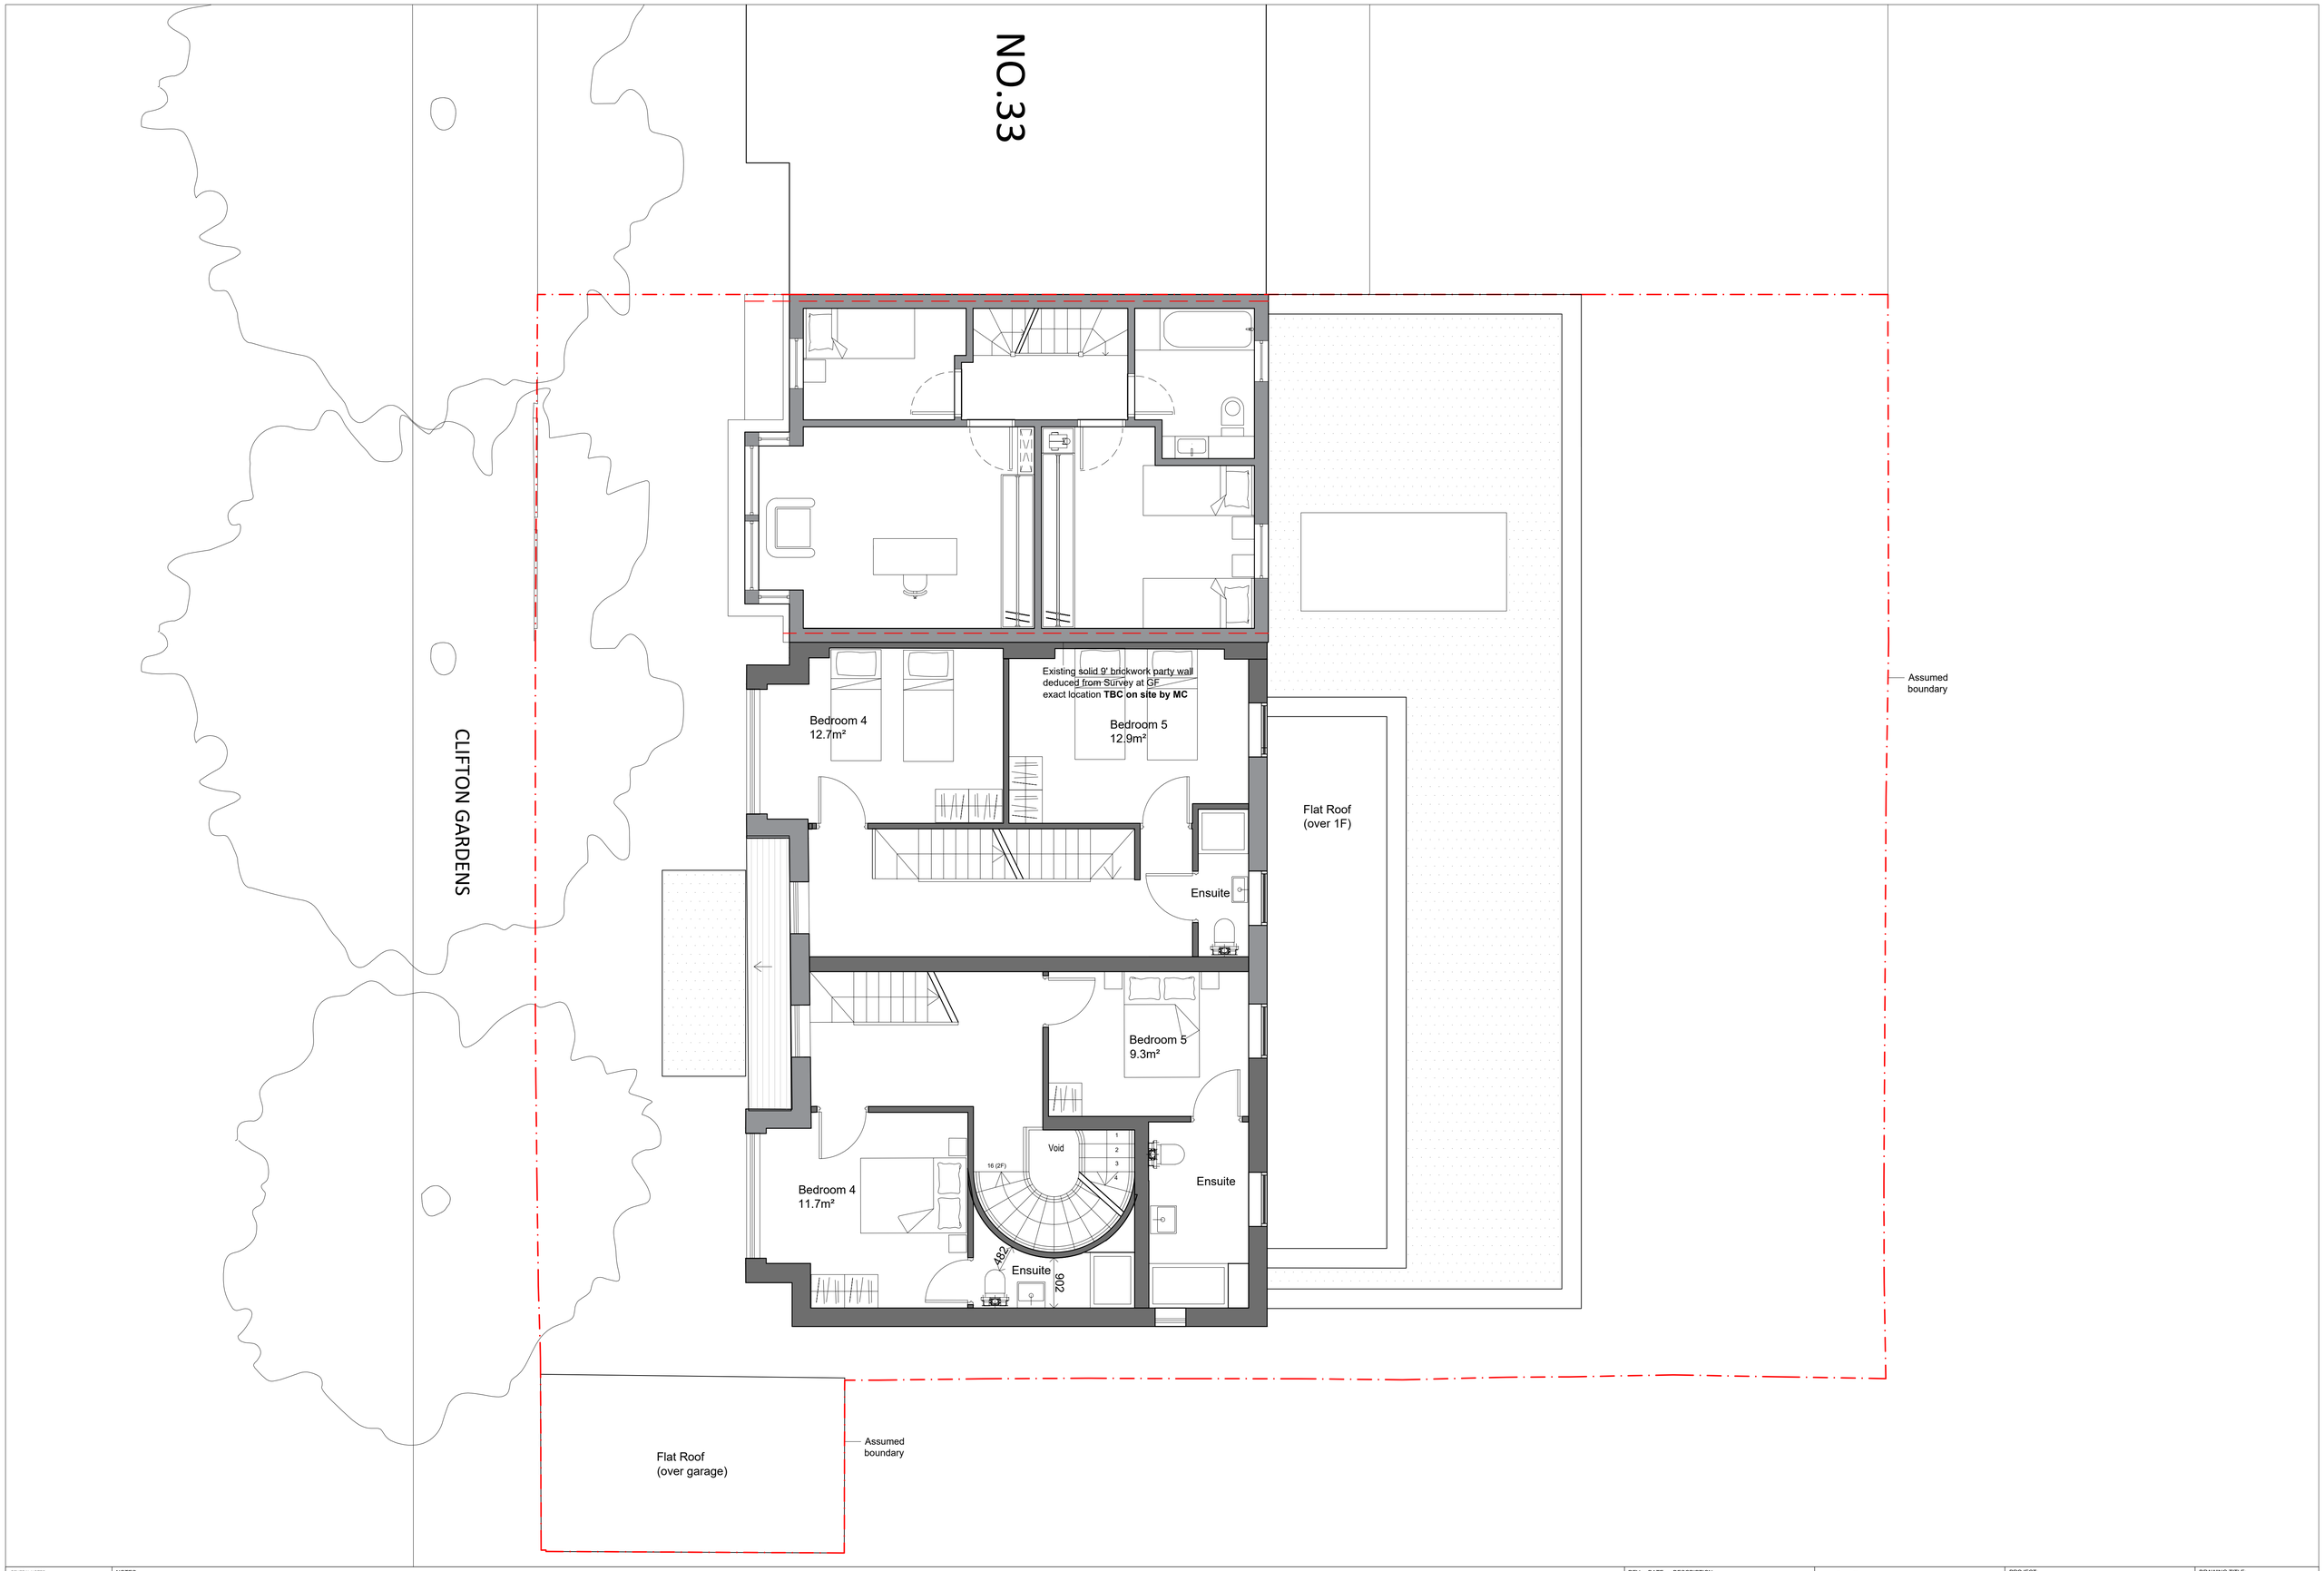

GENERAL NOTES:

USE FIGURED DIMENSIONS ONLY.
DO NOT SCALE OFF DRAWINGS.
ALL DIMENSIONS AND CONDITIONS TO BE CHECKED ON SITE.
INCONSISTENCIES ARE TO BE REPORTED TO OATEN ARCHITECTS IMMEDIATELY.

COPYRIGHT OF OATEN ARCHITECTS LTD.

NOTES:

1:50
0 1 2 3 4 5

REV.: DATE: DESCRIPTION:

OATEN ARCHITECTS
Oaten Architects Ltd,
33 West Street, Hastings, East Sussex, TN34 3AN
T 01424 256476
E office@oatenarchitects.com
W www.oatenarchitects.com

PROJECT:
35-39 Clifton Gardens N15 6AP

STAGE: Planning
SCALE: 1:50 @ A1 1:100@ A3
DRAWN BY - DATE: CT - 11/2020
CHECKED BY: RO
CLIENT: BMR Bagehot Ltd.

DRAWING TITLE:
Existing as-built 2F Plan

DRAWING NO: 20.1212 / 019
REV NO: -

GENERAL NOTES:

USE FIGURED DIMENSIONS ONLY.
DO NOT SCALE OFF DRAWINGS.
ALL DIMENSIONS ARE TO BE CHECKED ON SITE.
INCONSISTENCIES ARE TO BE REPORTED TO OATEN ARCHITECTS IMMEDIATELY.

COPYRIGHT OF OATEN ARCHITECTS LTD.

NOTES:

1:50

0 1 2 3 4 5

REV.: DATE: DESCRIPTION:

OATEN ARCHITECTS
Oaten Architects Ltd.
33 West Street, Hastings, East Sussex, TN34 3AN
T 01424 256476
E office@oatenarchitects.com
W www.oatenarchitects.com

PROJECT:
35-39 Clifton Gardens N15 6AP

STAGE: Planning
SCALE: 1:50 @ A1, 1:100@ A3
DRAWN BY - DATE: CT - 11/2020
CHECKED BY: RO
CLIENT: BMR Bagshot Ltd.

DRAWING TITLE:
Existing as-built 3F Plan

DRAWING NO: 20.1212 / 020
REV NO: -

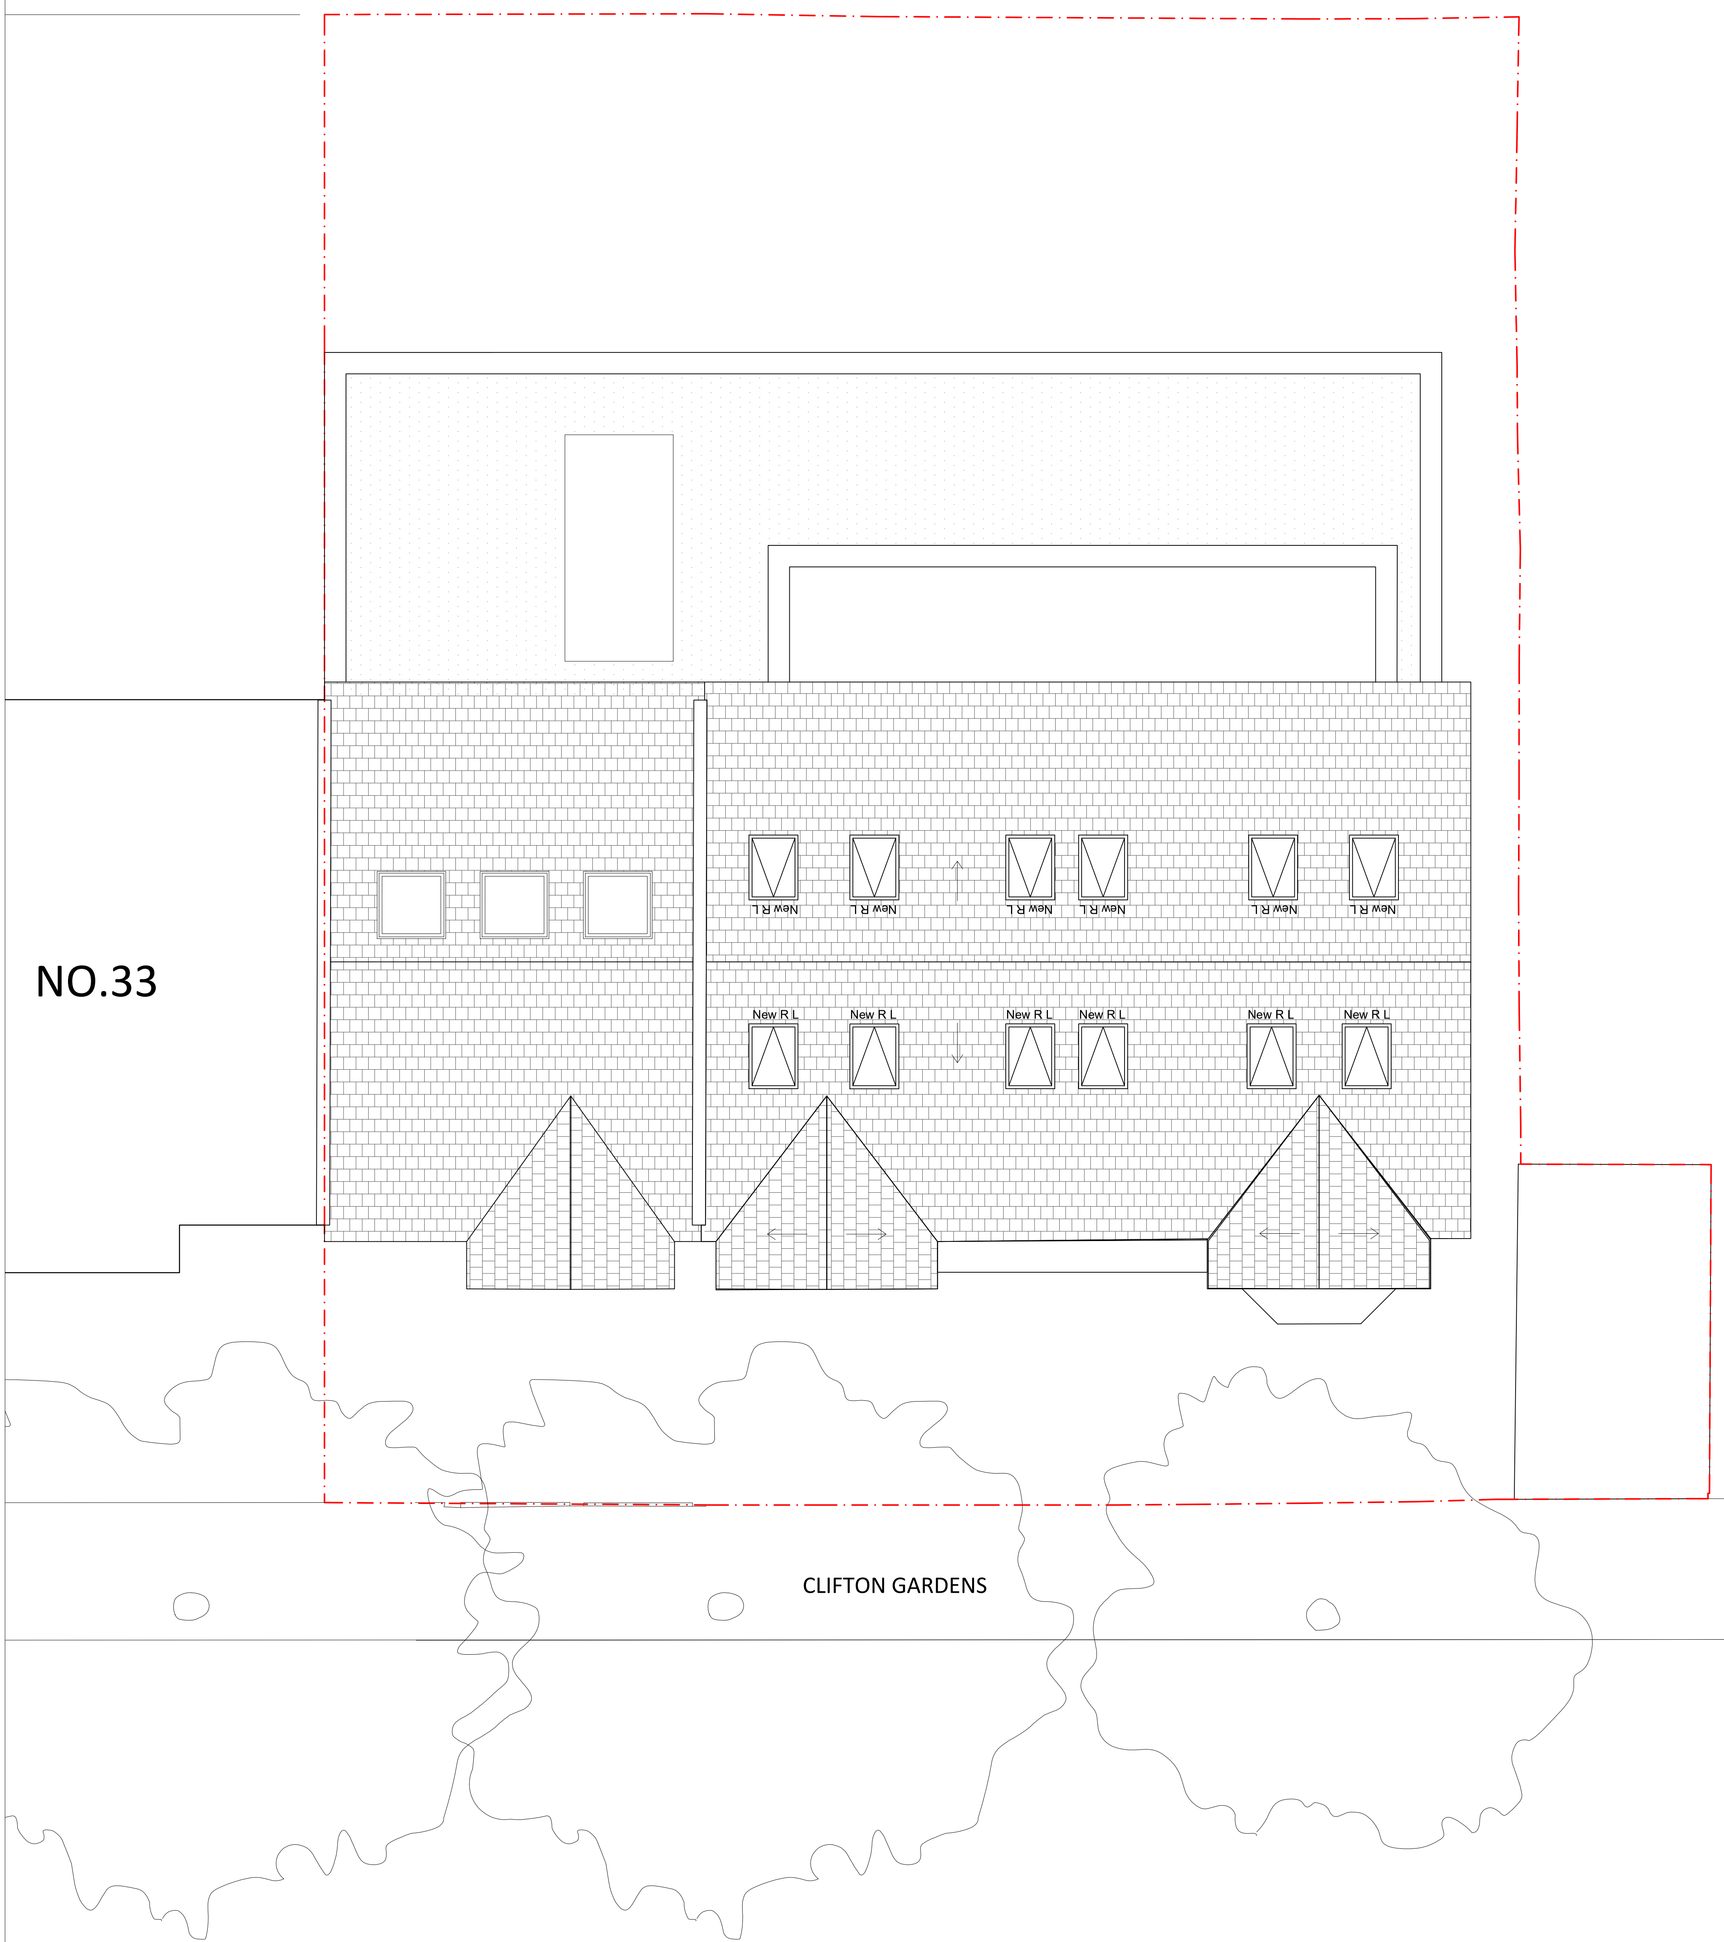

DRAWING TITLE:
Existing as-built Roof Plan

DRAWING NO.
20.1212 / 021

REV NO.
-

PROJECT:
35-39 Clifton Gardens N15 6AP

STAGE:
Planning

CLIENT:
BMR Bayshot Ltd.

SCALE:
1:50 @ A1
1:100@ A3

DRAWN BY - DATE:
CT - 11/2020

CHECKED BY:
RO

OATEN ARCHITECTS
Oaten Architects Ltd.
33 West Street, Hastings, East Sussex, TN34 3AN
T 01424 256476
E office@oatenarchitects.com
W www.oatenarchitects.com

REV.: DATE: DESCRIPTION:

1:50
0 1 2 3 4 5

NOTES:

GENERAL NOTES:
USE FIGURED DIMENSIONS ONLY.
DO NOT SCALE OFF DRAWINGS.
ALL DIMENSIONS ARE TO BE CHECKED ON SITE.
INCONSISTENCIES ARE TO BE REPORTED TO OATEN ARCHITECTS IMMEDIATELY.

COPYRIGHT OF OATEN ARCHITECTS LTD.

REAR ELEVATION (North)

GENERAL NOTES:

USE FIGURED DIMENSIONS ONLY.
DO NOT SCALE OFF DRAWINGS.
ALL DIMENSIONS ARE TO BE CHECKED ON SITE.
INCONSISTENCIES ARE TO BE REPORTED TO OATEN ARCHITECTS IMMEDIATELY.

COPYRIGHT OF OATEN ARCHITECTS LTD.

NOTES:

1:50
0 1 2 3 4 5

REV.: DATE: DESCRIPTION:

OATEN ARCHITECTS
Oaten Architects Ltd.
33 West Street, Hastings, East Sussex, TN34 3AN
T 01424 256476
E office@oatenarchitects.com
W www.oatenarchitects.com

PROJECT:
35-39 Clifton Gardens N15 6AP

STAGE: Planning
CLIENT: BMR Bagshot Ltd.
SCALE: 1:50 @ A1 1:100@ A3
DRAWN BY - DATE: CT - 11/2020
CHECKED BY: RO

DRAWING TITLE:
Existing as-built Rear (North) Elevation

DRAWING NO: 20.1212 / 022
REV NO: -

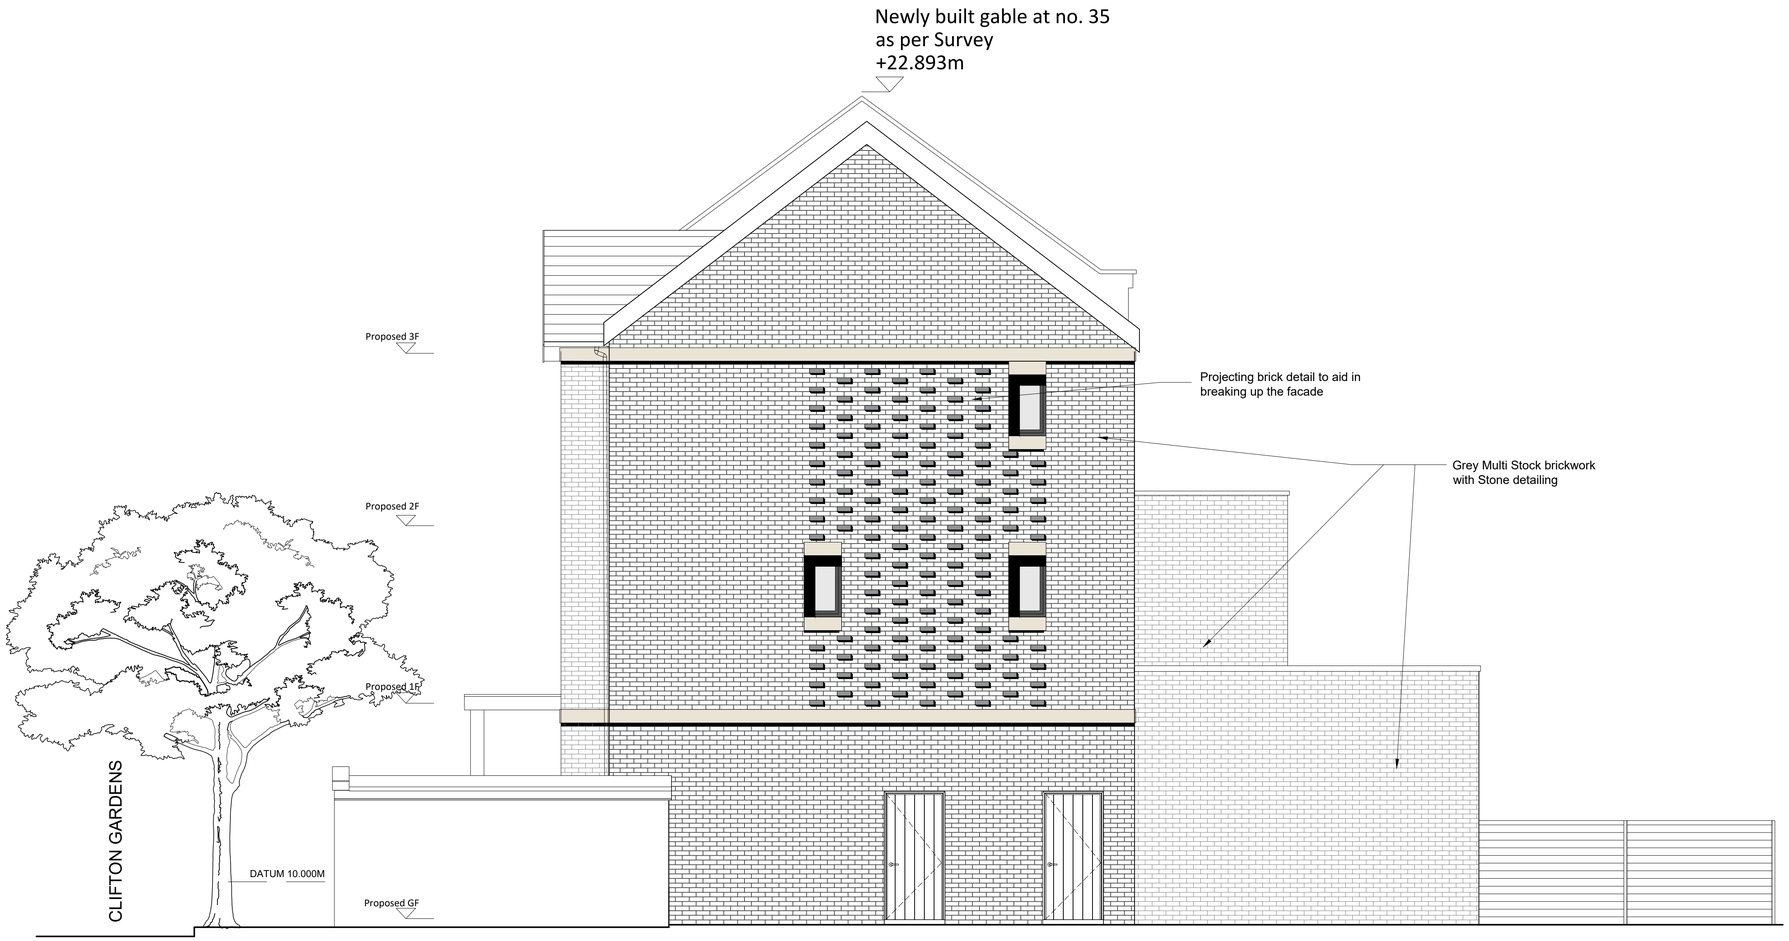

SIDE ELEVATION (East)

GENERAL NOTES:

USE FIGURED DIMENSIONS ONLY.
DO NOT SCALE OFF DRAWINGS.
ALL DIMENSIONS ARE TO BE CHECKED ON SITE.
INCONSISTENCIES ARE TO BE REPORTED TO
OATEN ARCHITECTS IMMEDIATELY.

COPYRIGHT OF OATEN ARCHITECTS LTD.

NOTES:

1:50

0 1 2 3 4 5

REV.: DATE: DESCRIPTION:

OATEN ARCHITECTS
Oaten Architects Ltd,
33 West Street, Hastings, East Sussex, TN34 3AN
T 01424 256476
E office@oatenarchitects.com
W www.oatenarchitects.com

PROJECT:
35-39 Clifton Gardens N15 6AP

STAGE:	SCALE:	DRAWN BY - DATE:
Planning	1:50 @ A1	CT - 11/2020
CLIENT: BMR Bagshot Ltd.	1:100@ A3	CHECKED BY: RO

DRAWING TITLE:
Existing as-built Side (East) Elevation

DRAWING NO: 20.1212 / 024

REV NO: -

FRONT ELEVATION (South)

GENERAL NOTES:

USE FIGURED DIMENSIONS ONLY.
DO NOT SCALE OFF DRAWINGS.
ALL DIMENSIONS ARE TO BE CHECKED ON SITE.
INCONSISTENCIES ARE TO BE REPORTED TO OATEN ARCHITECTS IMMEDIATELY.

COPYRIGHT OF OATEN ARCHITECTS LTD.

NOTES:

1:50

0 1 2 3 4 5

REV.:	DATE:	DESCRIPTION:
A	4/12/23	

OATEN ARCHITECTS
Oaten Architects Ltd,
33 West Street, Hastings, East Sussex, TN34 3AN
T 01424 256476
E office@oatenarchitects.com
W www.oatenarchitects.com

PROJECT:
37-39 Clifton Gardens N15 6AP

STAGE: Planning
CLIENT: BMR Bagshot Ltd.
SCALE: 1:50 @ A1 1:100@ A3
DRAWN BY - DATE: CT - 11/2020
CHECKED BY: RO

DRAWING TITLE:
Existing as-built front (South) elevation

DRAWING NO: 20.1212 / 110
REV NO: A