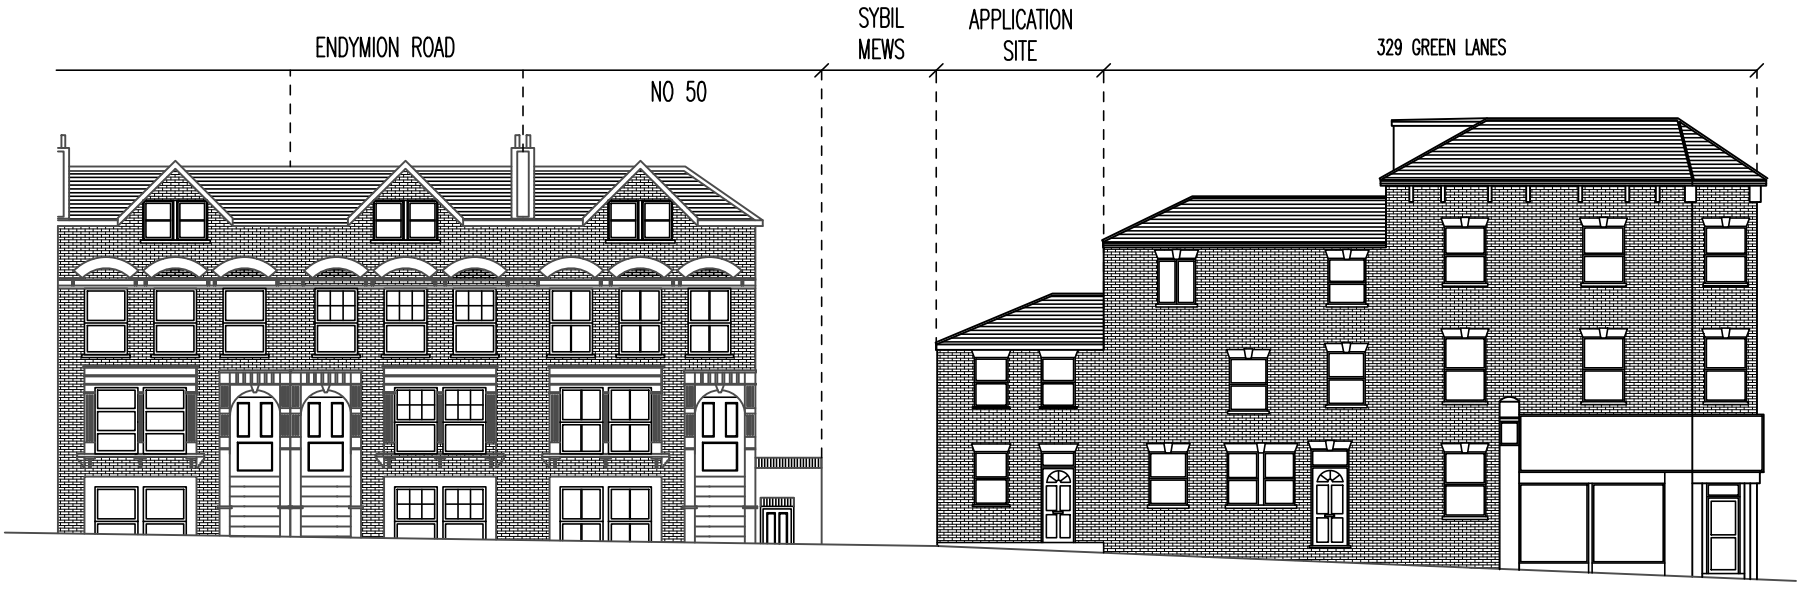

ELEVATION AS GRANTED PLANNING PERMISSION

ELEVATION AS BUILT (EXISTING)

ELEVATION AS PROPOSED

COLOURED ELEVATION – NOT TO SCALE

ISSUED FOR PLANNING PERMISSION ONLY

SCALE
METERS 2 4 6 8

THE COPYRIGHT OF THIS DRAWING BELONGS TO THE ARCHITECT AND MAY NOT BE ALTERED WITHOUT THE ARCHITECT'S WRITTEN CONSENT

BUILDING REGULATION APPROVAL IS REQUIRED PRIOR TO CONSTRUCTION COMMENCING
THE CONTRACTOR IS TO CHECK ALL DIMENSIONS ON SITE PRIOR TO CONSTRUCTION COMMENCING AND REPORT ANY DISCREPANCIES TO THE ARCHITECT

REV	DATE	DESCRIPTION

WWW.IBIDESIGN.COM
IBI DESIGN ASSOCIATES
CHARTERED ARCHITECTS AND DESIGNERS
59 CHELMSFORD ROAD, LONDON N14 5PY
T: 020 8447 8434 F: 020 8447 8448
e-mail: ibides@aol.com

PROJECT 51 ENDYMION ROAD, LONDON N4 1EQ

DRAWING TITLE
STREET ELEVATION OF ENDYMION ROAD

SCALE 1:200 @ A3 DATE OCTOBER 2023

PROJECT No.
HA/329/PP05