


Option with Sprinkler

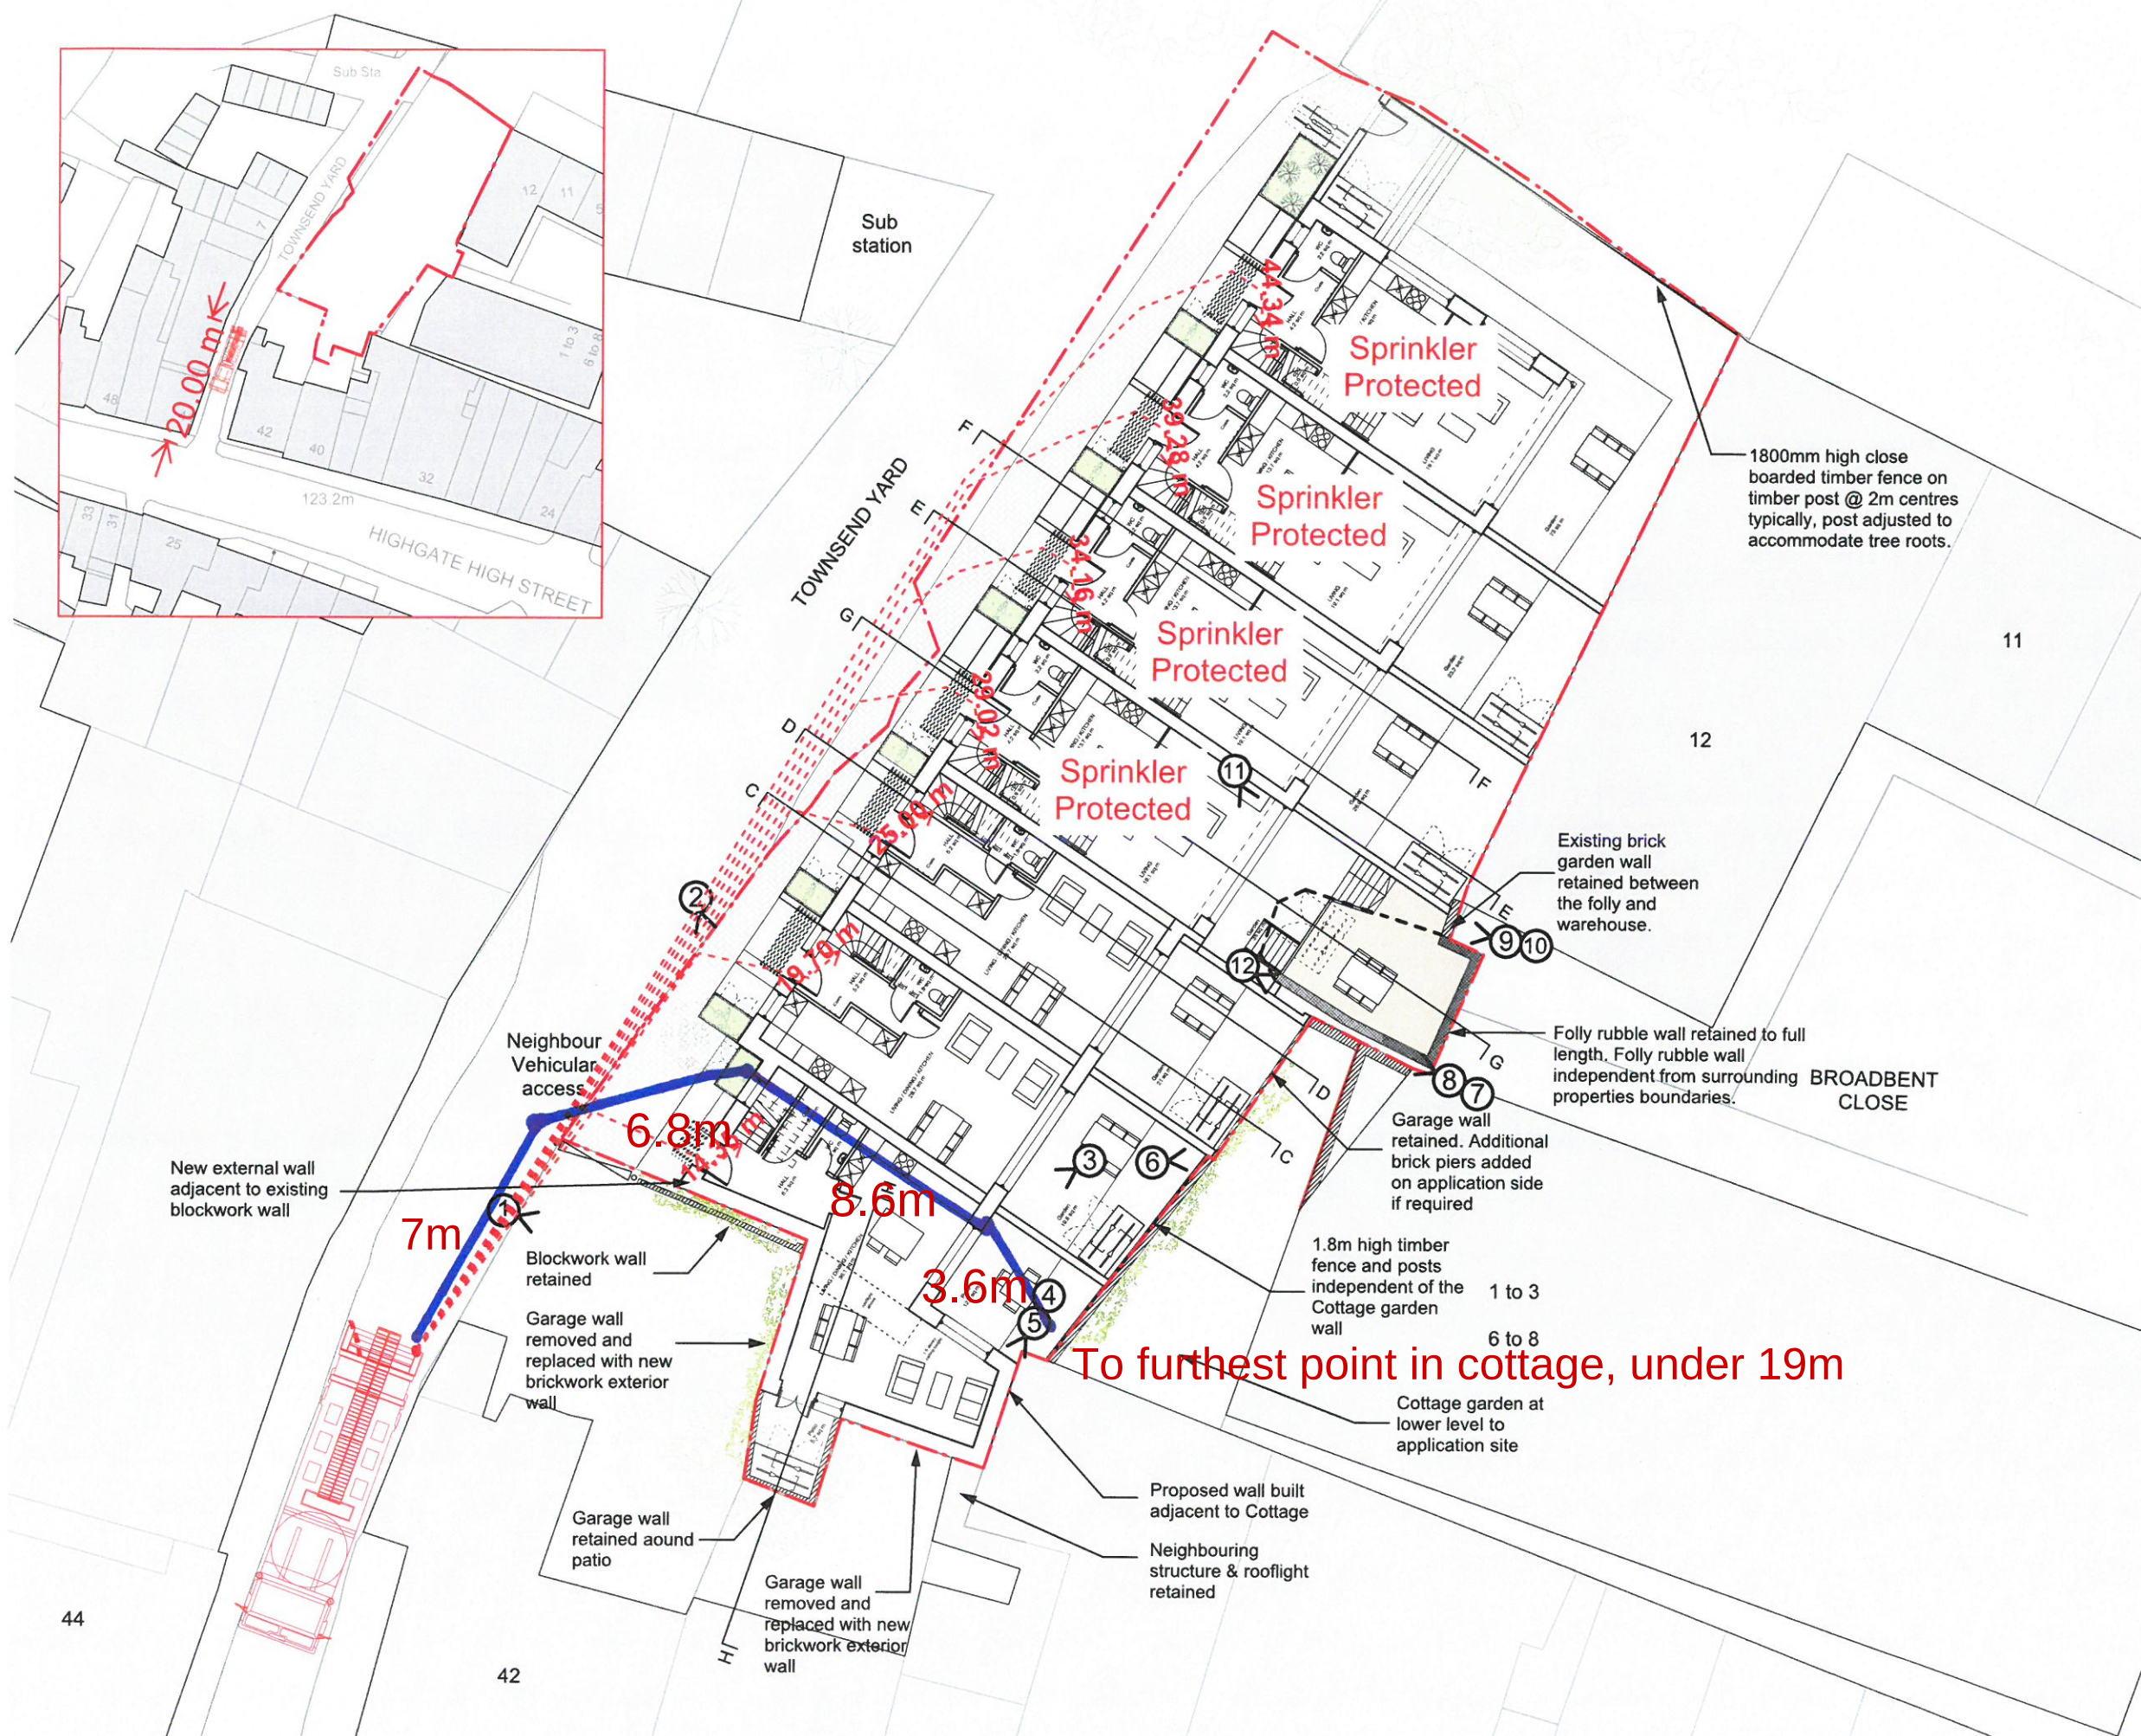

Mark-up Legend

- | | |
|---|-----------------------------------|
|  | 60 minutes fire resistance |
|  | 30 minutes fire resistance |
|  | FD60S Fire door |
|  | FD30S Fire door Self-Closing |
|  | FD30 Fire door |
|  | FD20 Fire door Not Self - Closing |
|  | Travel distance |
|  | Hose distance |
|  | Heat Detectors |
|  | Smoke Detectors |
|  | Smoke Vent Switch |
|  | Protected Stair |
|  | Protected Common lobby |
|  | Protected Entrance Hall |



Project: Townsend Yard

Title: Fire Safety Mark-ups Vehicle Access

Revision: Issue 1.0 Scale: 1:200 @ A3

Prepared by: G.Marinozzi Date: 15/05/23

Checked by: K.Walia Date: 15/05/23