

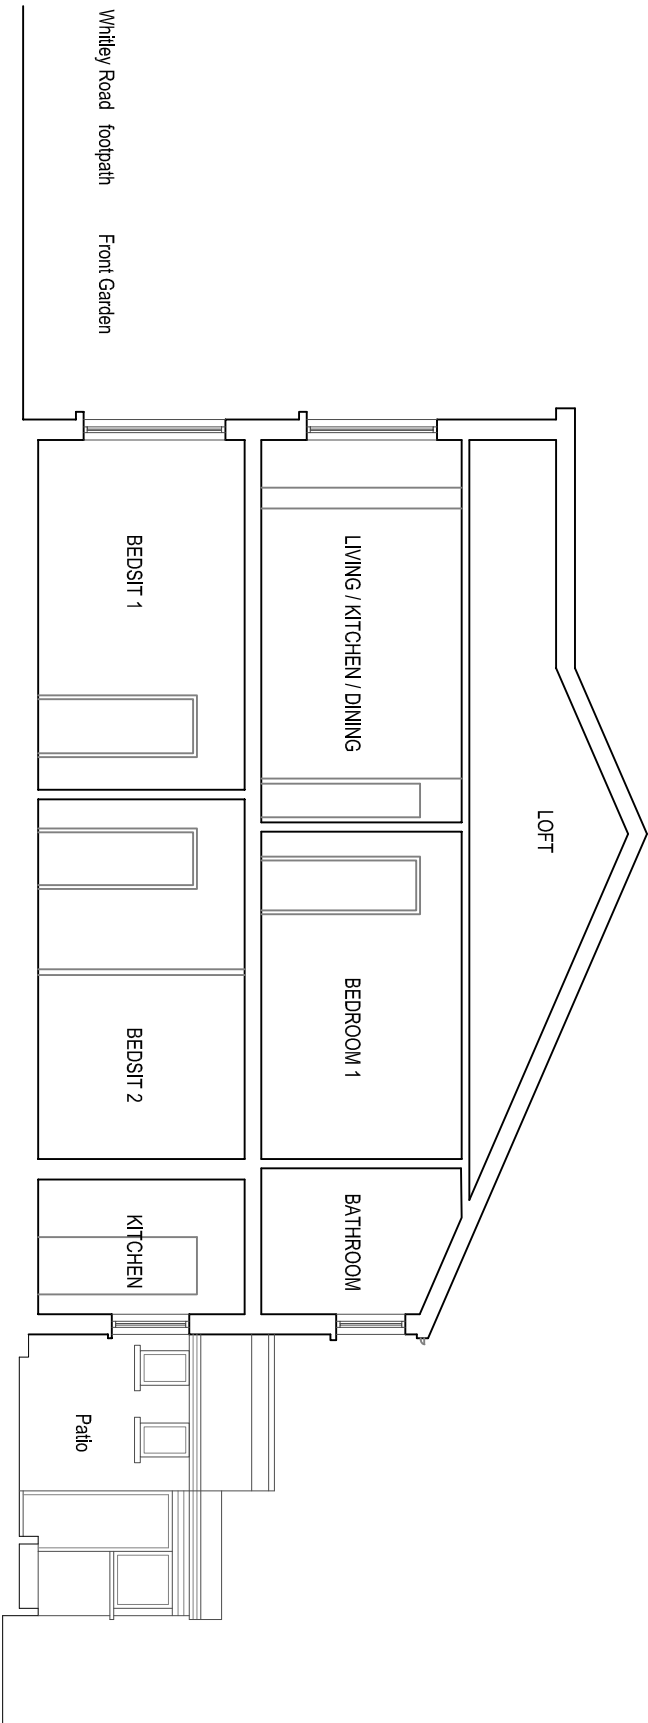


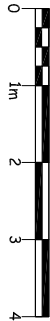

PREVIOUSLY EXISTING SECTION A-A

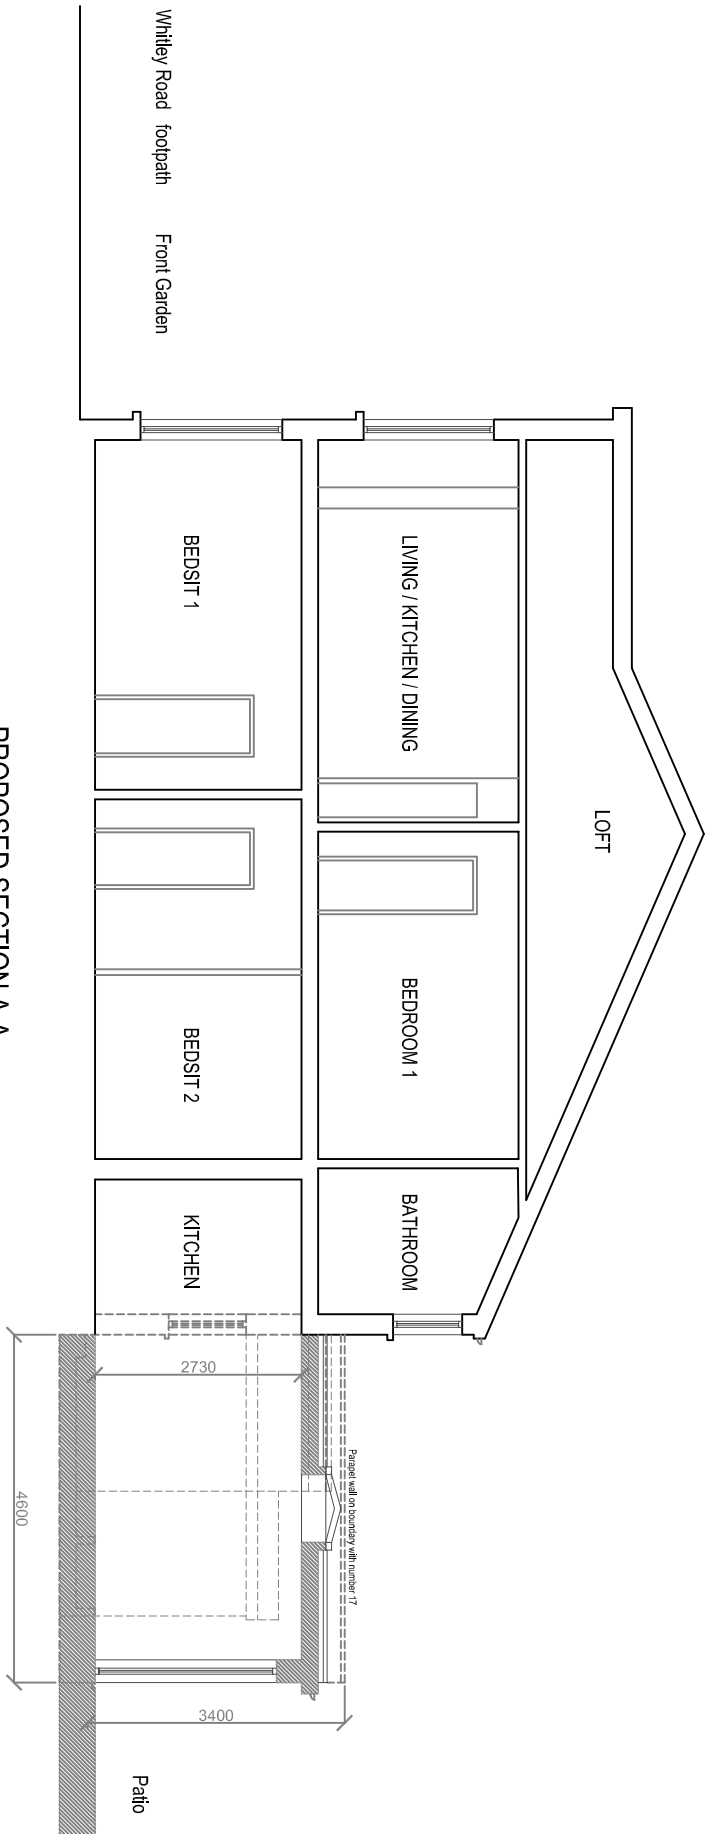

PROPOSED SECTION A-A

|   |                                                              |   |                     |   |             |
|---|--------------------------------------------------------------|---|---------------------|---|-------------|
| Project<br>Retention of As Built 4.6m<br>Single Storey Rear Extension<br>At 17 Whitley Road,<br>Tottenham, London, N17 6RJ | Sheet Title<br>Previously Existing &<br>Proposed Section A-A | Notes<br><br>Do not scale these drawings. Any discrepancies<br>noted are to be reported to RIBO Associates Ltd<br>immediately | Drawn by<br>RB      |  <b>RIBO ASSOCIATES LTD</b><br>Architectural Consultants<br>51 Hassocks Road, Streatham Vale,<br>London SW16 5HA<br>Tel: 020 8617 9182 / 07946 872 604<br>E: ribo.arch@gmail.com | Drawing No. |
|   | Revisions                                                    |   | Scale<br>1:100 @ A3 |   | 13<br>of    |
|   |                                                              |   | Date<br>Oct 2023    |   |             |
|   |                                                              |   | Job No.<br>17WR/P2  |   |             |