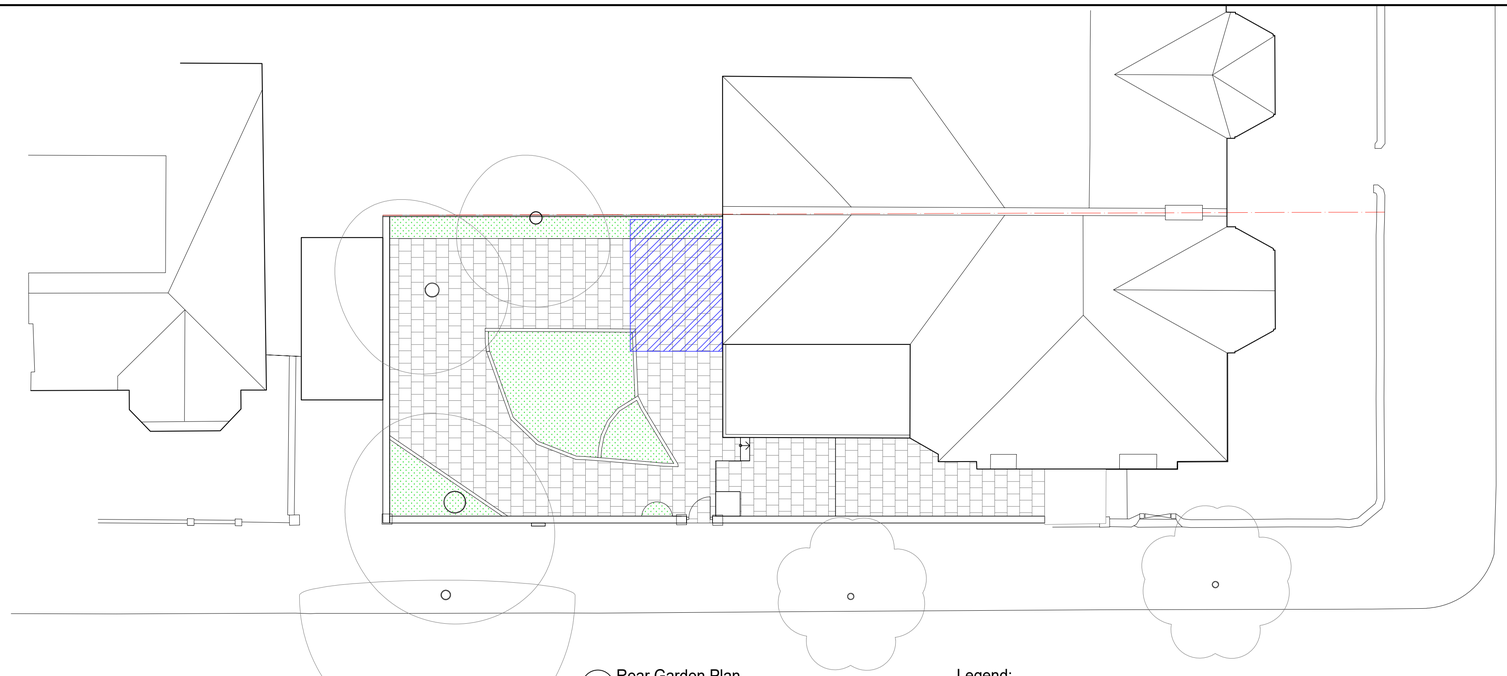

1 Rear Garden Plan
Initial
Scale 1:100

0 1 2 3 4 5m
1:100

Legend:
Hard surface paving
Soft standing/lawn
Surface drainage fall
Pergola

Cumulative green permeable area 27.2sqm

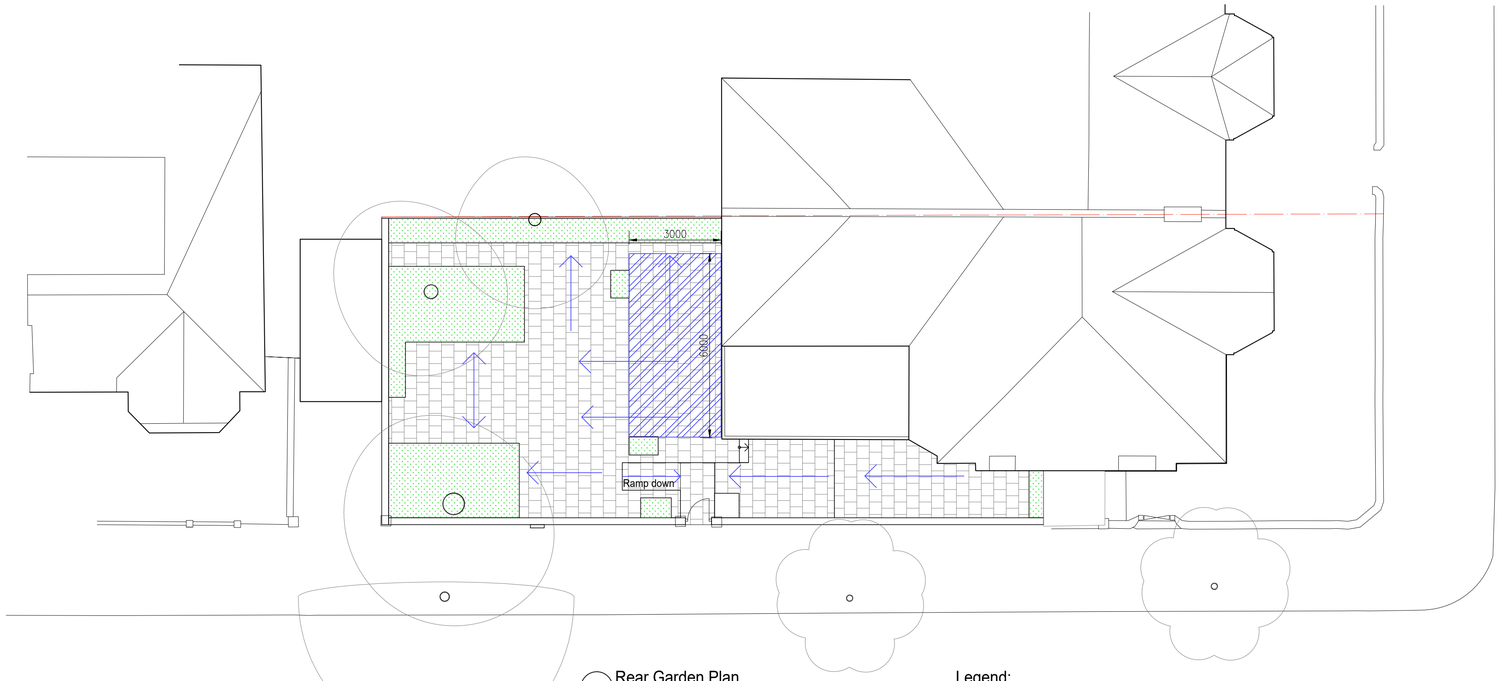

1 Rear Garden Plan
As Built
Scale 1:100

0 1 2 3 4 5m
1:100

Legend:
Hard surface paving
Soft standing/lawn
Surface drainage fall
Pergola

Cumulative green permeable area 33sqm

Notes:

1. THE COPYRIGHT OF THIS DRAWING IS VESTED IN GAMUT BUILDING

REV:	DESCRIPTION:	BY:	DATE:
B	Ex Pergola	MP	04/03/24
A	First Issue	MP	04/03/24

STATUS: Planning Issue

GAMUT BUILDING SOLUTIONS
Gamut Building Solutions
The Lightbox, Unit 1.57
111 Power Road, London, W4 5PY
T: 0208 0013 515 M: 074 032 44 240
info@GamutBS.co.uk
www.GamutBS.co.uk

CLIENT: Siobhan McMillan

SITE: 1A Dukes Avenue
LONDON, N10 2QE

TITLE: Exisitng and Proposed
Site and Garden Plans

SCALE AT A1:	DATE:	DRAWN:	CHECKED:
1:100	March 2024	MP	-

PROJECT NO:	DRAWING NO:	REVISION:
00523	PL402	B