


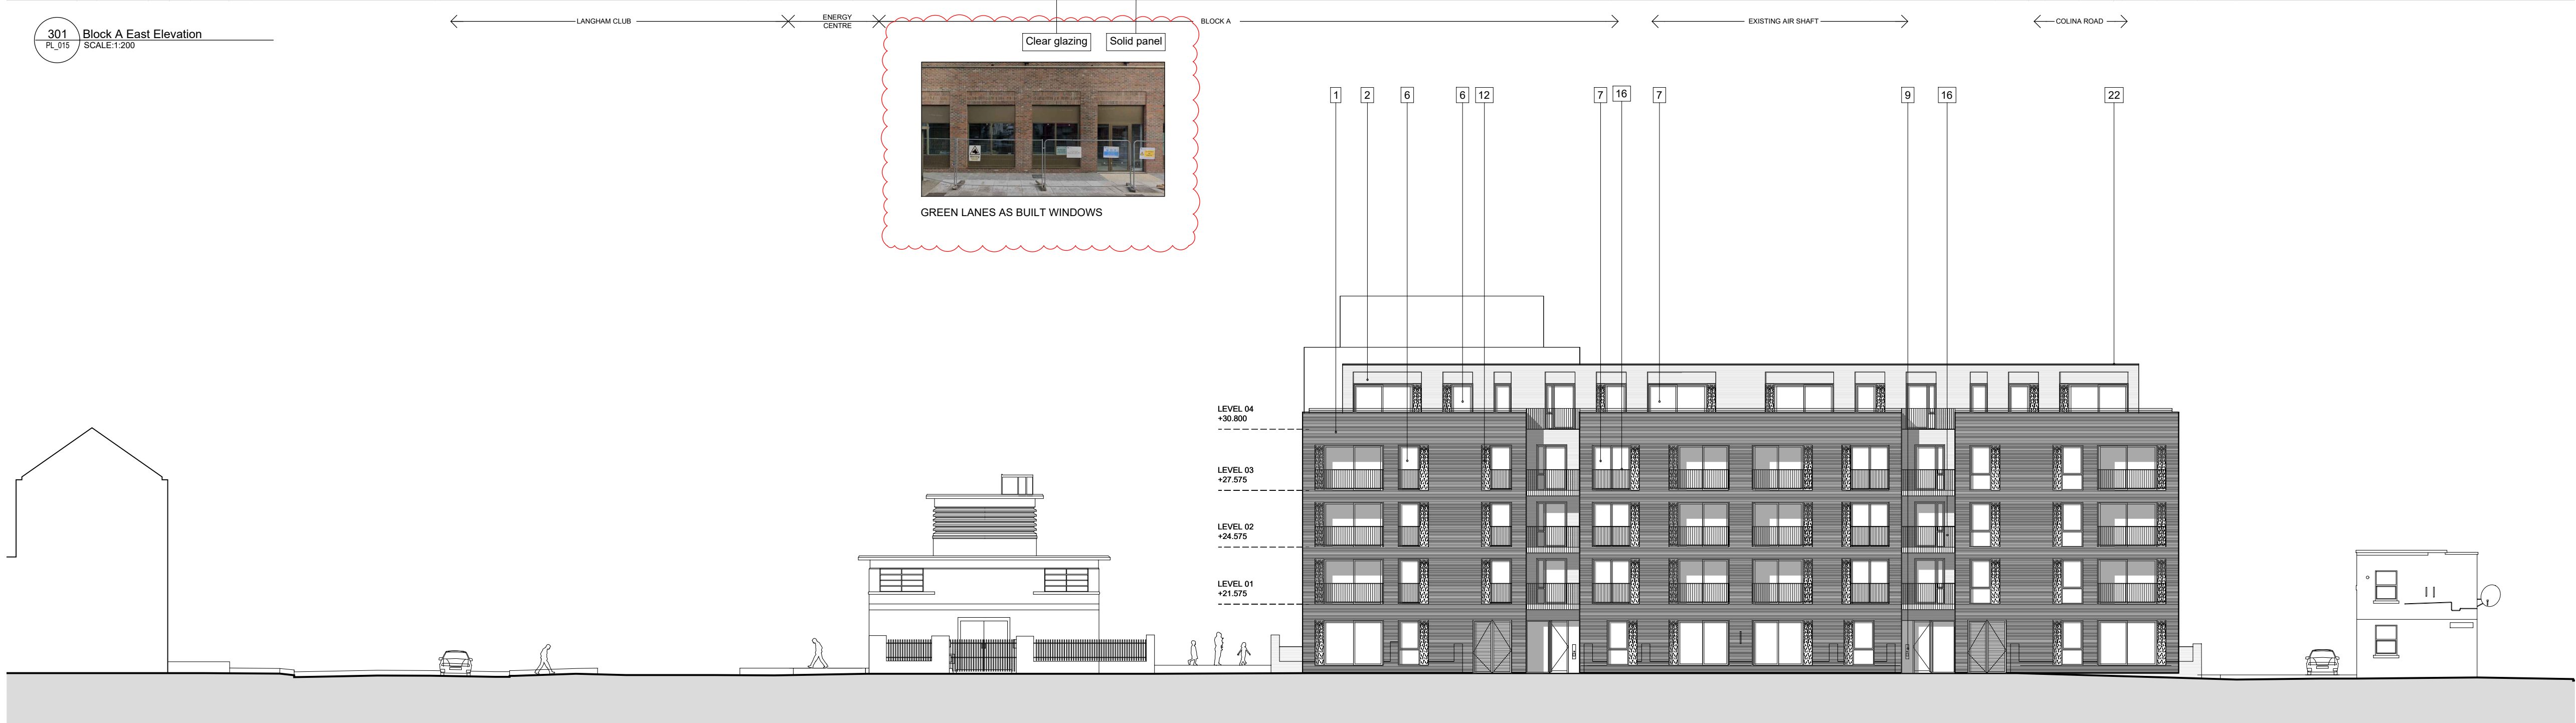


301 Block A East Elevation
PL_015 SCALE:1:200



302 Block A D & E South Elevation
PL_015 SCALE:1:200



303 Block F East Elevation
PL_015 SCALE:1:200

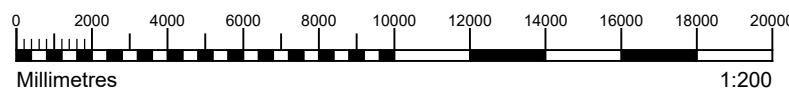

GENERAL NOTES

This drawing is © 2023 PTE architects

Use figured dimensions only. DO NOT SCALE.

All dimensions are in millimetres unless noted otherwise

All levels are in metres above ordnance datum unless noted otherwise

This drawing must be read in conjunction with all other relevant drawings and specifications from the Architect and other consultants

If in doubt, ask

Materials Key and Notes:

Brick:

- 1 - Facing brickwork type 1 - Lighter
- 2 - Facing Brickwork type 2 - Darker
- 3 - Facing brickwork type 1 - Laid flemish bond (with projecting headers)
- 4 - Recessed vertical brick panel
- 5 - Soldier course

Windows / Doors:

- 6 - Windows and doors: PPC Aluminium/timber composite windows set within brickwork.
- 7 - Sliding doors: PPC Aluminium/timber composite.
- 8 - Window joinery to ground floor Block A to be resolved after use finalised
- 9 - PPC vertical aluminium entrance signage panel / intercom.
- 10 - PPC Aluminium oriel window with obscure window to south east and clear operable window to north east.
- 11 - Painted solid core entrance door with glazed side light.
- 12 - PPC vertical perforated aluminium panel with operable window behind.
- 13 - PPC metal louvred doors to match window joinery.

Cladding:

- 14 - Lightweight PPC metal cladding

Balconies / Terraces:

- 15 - Solid PPC metal balustrade.
- 16 - PPC metal balustrade to match window joinery.
- 17 - Cantilevered balconies to flats to have timber decking.
- 18 - PPC folded aluminium surround to window & recessed balcony soffit to match window joinery.
- 19 - Roof terraces to have smooth ground concrete paving.
- 20 - Boundary light steel railing.

Gates:

- 21 - Metal gate.

Roof / Parapets / Soffits:


- 22 - Metal parapet capping.
- 23 - Stone parapet capping.
- 24 - PPC folded aluminium canopy with integrated lighting.

Mews:

- 25 - Metal handrail to landscaped steps.
- 26 - Brick planter

Energy Centre

- 27 - Brickwork type 3. Dark brick, typical flemish bond. Hit & miss sections
- 28 - Brickwork type 4. Dark brick, typical flemish bond

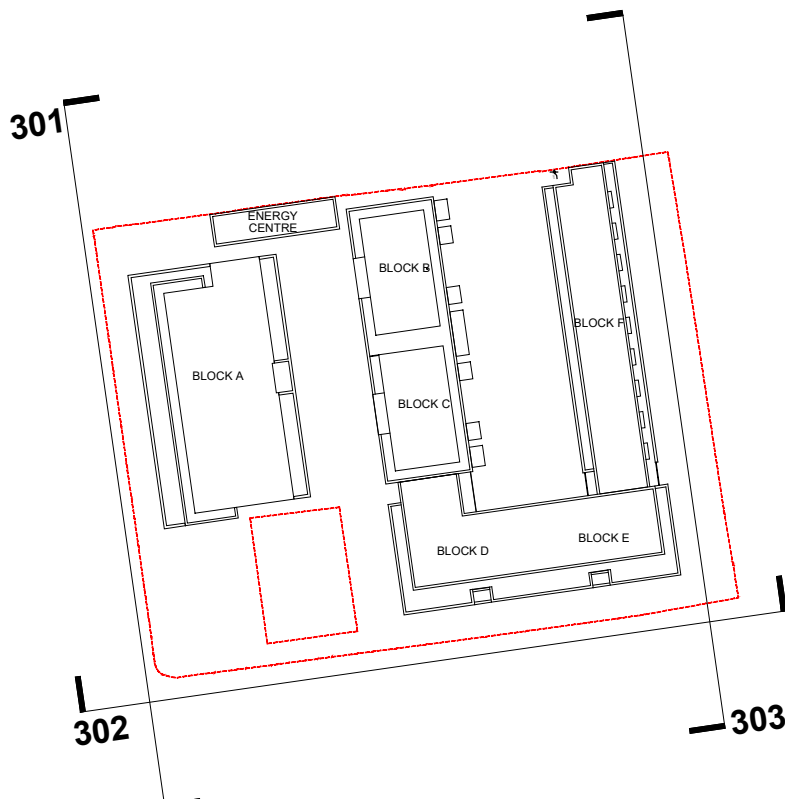

ELEVATION KEY
SCALE 1:1250

C	27.10.2023	Elevation 301 ground floor windows and energy centre updated to as built	RH	
B	14.12.2022	Ground floor openings updated	RH	
A	10.08.2016	Oriel windows added to Block F. Window types amended across all blocks	DH	DPD
/	09.06.2016	Issued for planning	DH	DPD
rev	date	description	drawn	audited
drawing status				

PLANNING

Diespeker Wharf
38 Graham Street
London N1 8JY
020 7336 7777
forename.surname@pte.co.uk
@ptearchitects
www.pollardthomasedwards.co.uk

Pollard
Thomas
Edwards

project	job no.	drawn	audited	scale	date
590-598 Green Lanes Haringey, London	16-028	DH	DPD	1:200@A1	Jun'16
drawing title	drawing number	revision			
General Arrangement Proposed Elevations 1	028_PL_015	C			
C:\USER\ROGER.HOLDSWORTH\HONEY - POLLARD THOMAS EDWARDS\DESKTOP\GREEN LANES\028_PL_015 PROPOSED ELEVATIONS 1.DWG					

