




ALUMINIUM EDGING

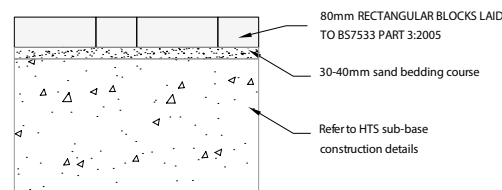


CONCRETE BLOCK PAVING
CONSTRUCTION WITH REGULAR
VEHICULAR LOADING

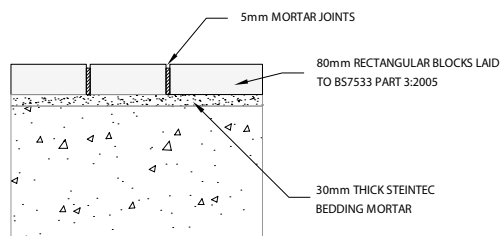


GRANITE PAVING WITHIN PEDESTRIAN
ZONE AND ENTRANCE THRESHOLD

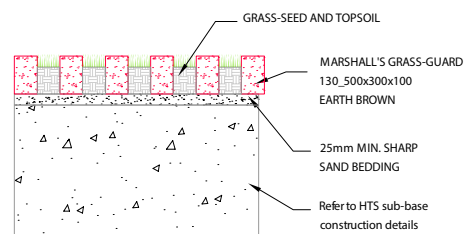


GRASS-GUARD PARKING BAY
CONSTRUCTION WITH REGULAR
VEHICULAR LOADING

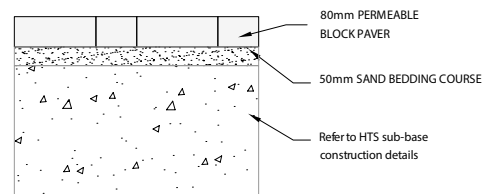


PERMEABLE BLOCK PAVING
CONSTRUCTION WITH REGULAR
VEHICULAR LOADING

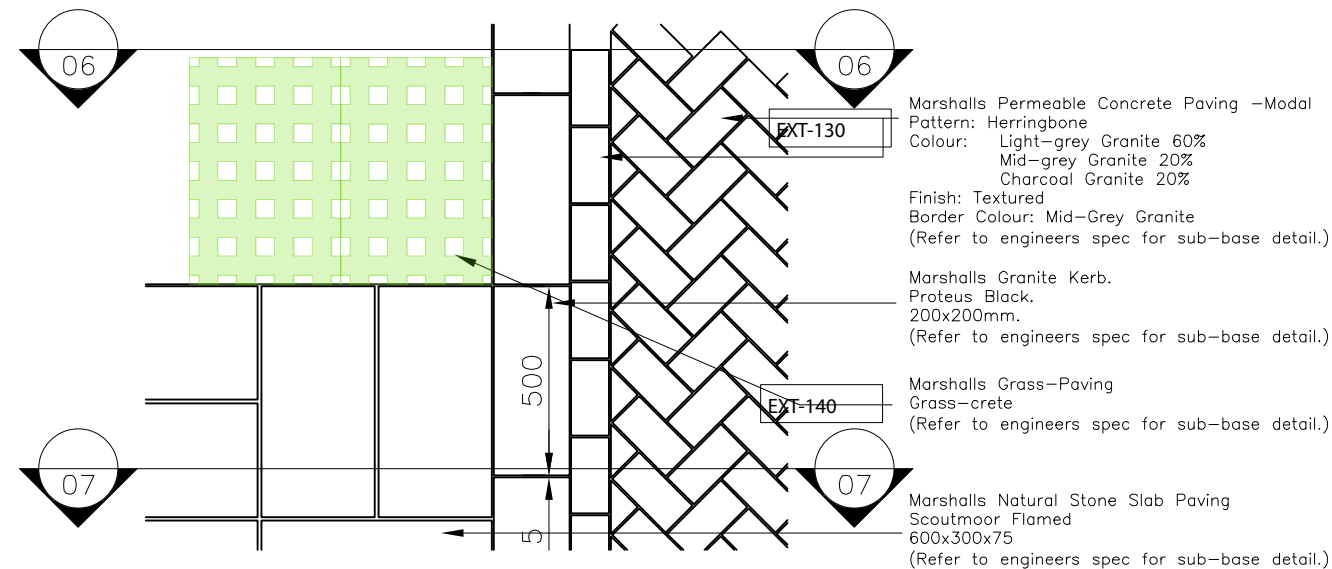

1:20 - Residential Paving Interfaces - Plan

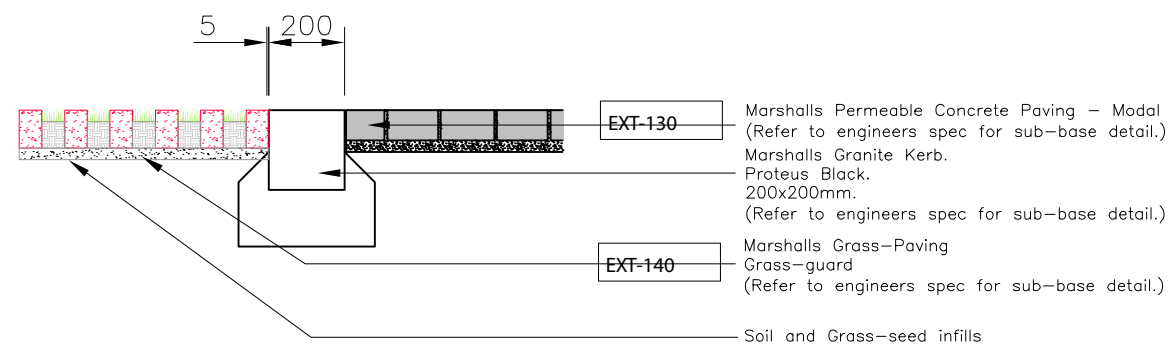

Section 06
1:20 - Residential Paving Interfaces -
Grass-paving, Kerb and Herringbone section

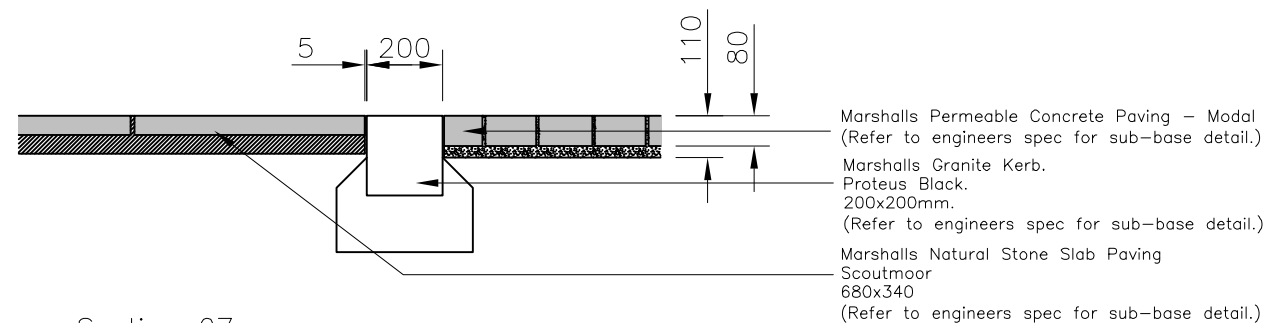

Section 07
1:20 - Residential Paving Interfaces -
Yorkstone, Kerb and Herringbone section

Notes:

1. THE COPYRIGHT OF THIS DRAWING IS VESTED IN GREENSIDE LANDSCAPES AND IT MAY NOT BE REPRODUCED IN WHOLE OR PART OR USED FOR THE MANUFACTURE OF ANY ARTICLE WITHOUT THE EXPRESS PERMISSION OF THE COPYRIGHT HOLDERS.
2. WORK TO FIGURED DIMENSIONS ONLY.
3. THIS DRAWING IS TO BE READ IN CONJUNCTION WITH ALL RELEVANT ARCHITECT'S, SERVICE ENGINEER'S AND GREENSIDE LANDSCAPES SPECIFICATIONS.



LIGHT-GREY - TEXTURED



MID-GREY - TEXTURED



CHARCOAL GREY - TEXTURED

AB	AS BUILT	LF	12.10.22
P01	Additional colour added	LF	06/08/20
REV:	DESCRIPTION:	BY:	DATE:
STATUS: AS BUILT			



CLIENT:
ARCHITECT:

SITE:	Hornsey Town Hall		
TITLE:	Typical Paving Application Main Access Slope - Block A-B		
SCALE AT A3:	DATE:	DRAWN:	CHECKED:
1:20	16.07.20	LF	
PROJECT NO:	DRAWING NO:	REVISION:	
HTH_20	GSL_P2.01_001	AB	