





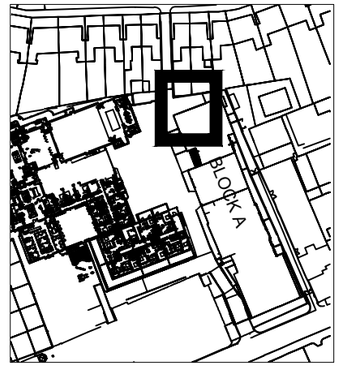

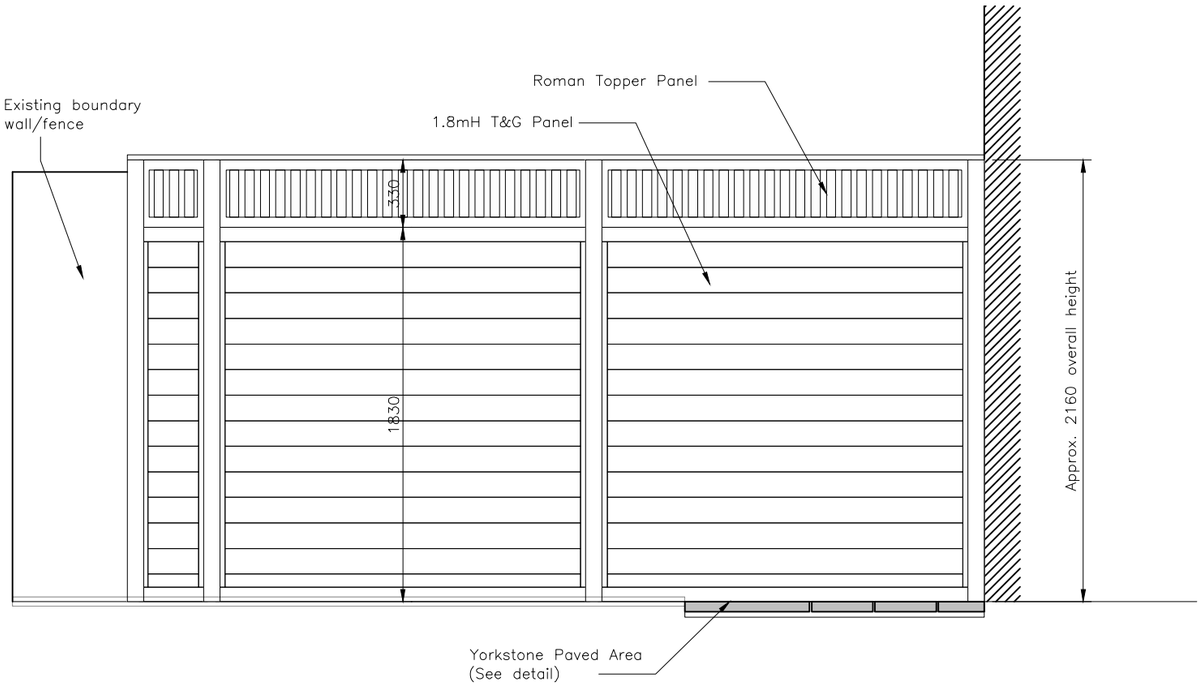


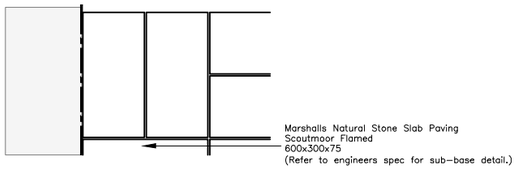

1:30 – Residential Paving Interfaces – Plan

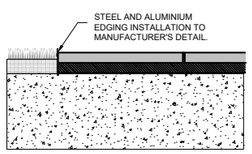

1:30 – Residential Paving Interfaces
Yorkstone and Lawn section

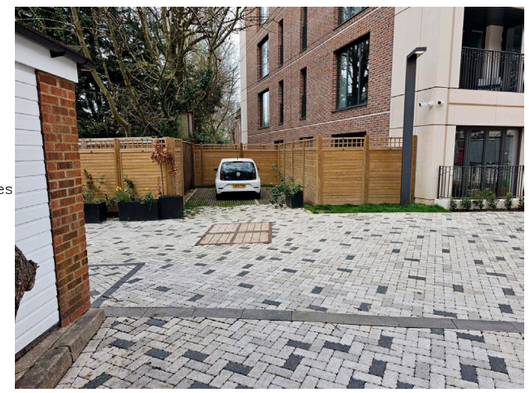

Notes:

1. THE COPYRIGHT OF THIS DRAWING IS VESTED IN FITTALL DESIGNS/GREENSIDE AND IT MAY NOT BE REPRODUCED IN WHOLE OR PART OR USED FOR THE MANUFACTURE OF ANY ARTICLE WITHOUT THE EXPRESS PERMISSION OF THE COPYRIGHT HOLDERS.
2. WORK TO FIGURED DIMENSIONS ONLY.
3. THIS DRAWING IS TO BE READ IN CONJUNCTION WITH ALL RELEVANT ARCHITECT'S, SERVICE ENGINEER'S AND FITTALL DESIGNS/GREENSIDE AND SPECIFICATIONS.

- Aluminium Edging
- Raised Steel Planter
- Structural Retaining Wall
- Drainage Channel
- Herringbone Paving 200x100 Granite
- Herringbone Permeable Paving 200x100 Granite
- GrassCrete
- Basket Weave Paving 400x200 Light Granite
- Grass Area
- Handrail/Balustrade
- Privacy Screens/Fence
- Josta 2-tier bike rack system

REV:	DESCRIPTION:	BY:	DATE:
AB	AS BUILT	LF	12.10.22

STATUS: AS BUILT

GREENSIDE LANDSCAPES
Unit 45, Golds Business Park, Jenkins Drive, Elsenham, Essex, CM22 6JX

CLIENT:

ARCHITECT:

SITE: Hornsey Town Hall

TITLE: Block A – North Marketing Suite Garden

SCALE AT A3:	DATE:	DRAWN:	CHECKED:
1:100	15/02/20	LF	

PROJECT NO:	DRAWING NO:	REVISION:
HTH_20.03	GSL_P1_012	AB