


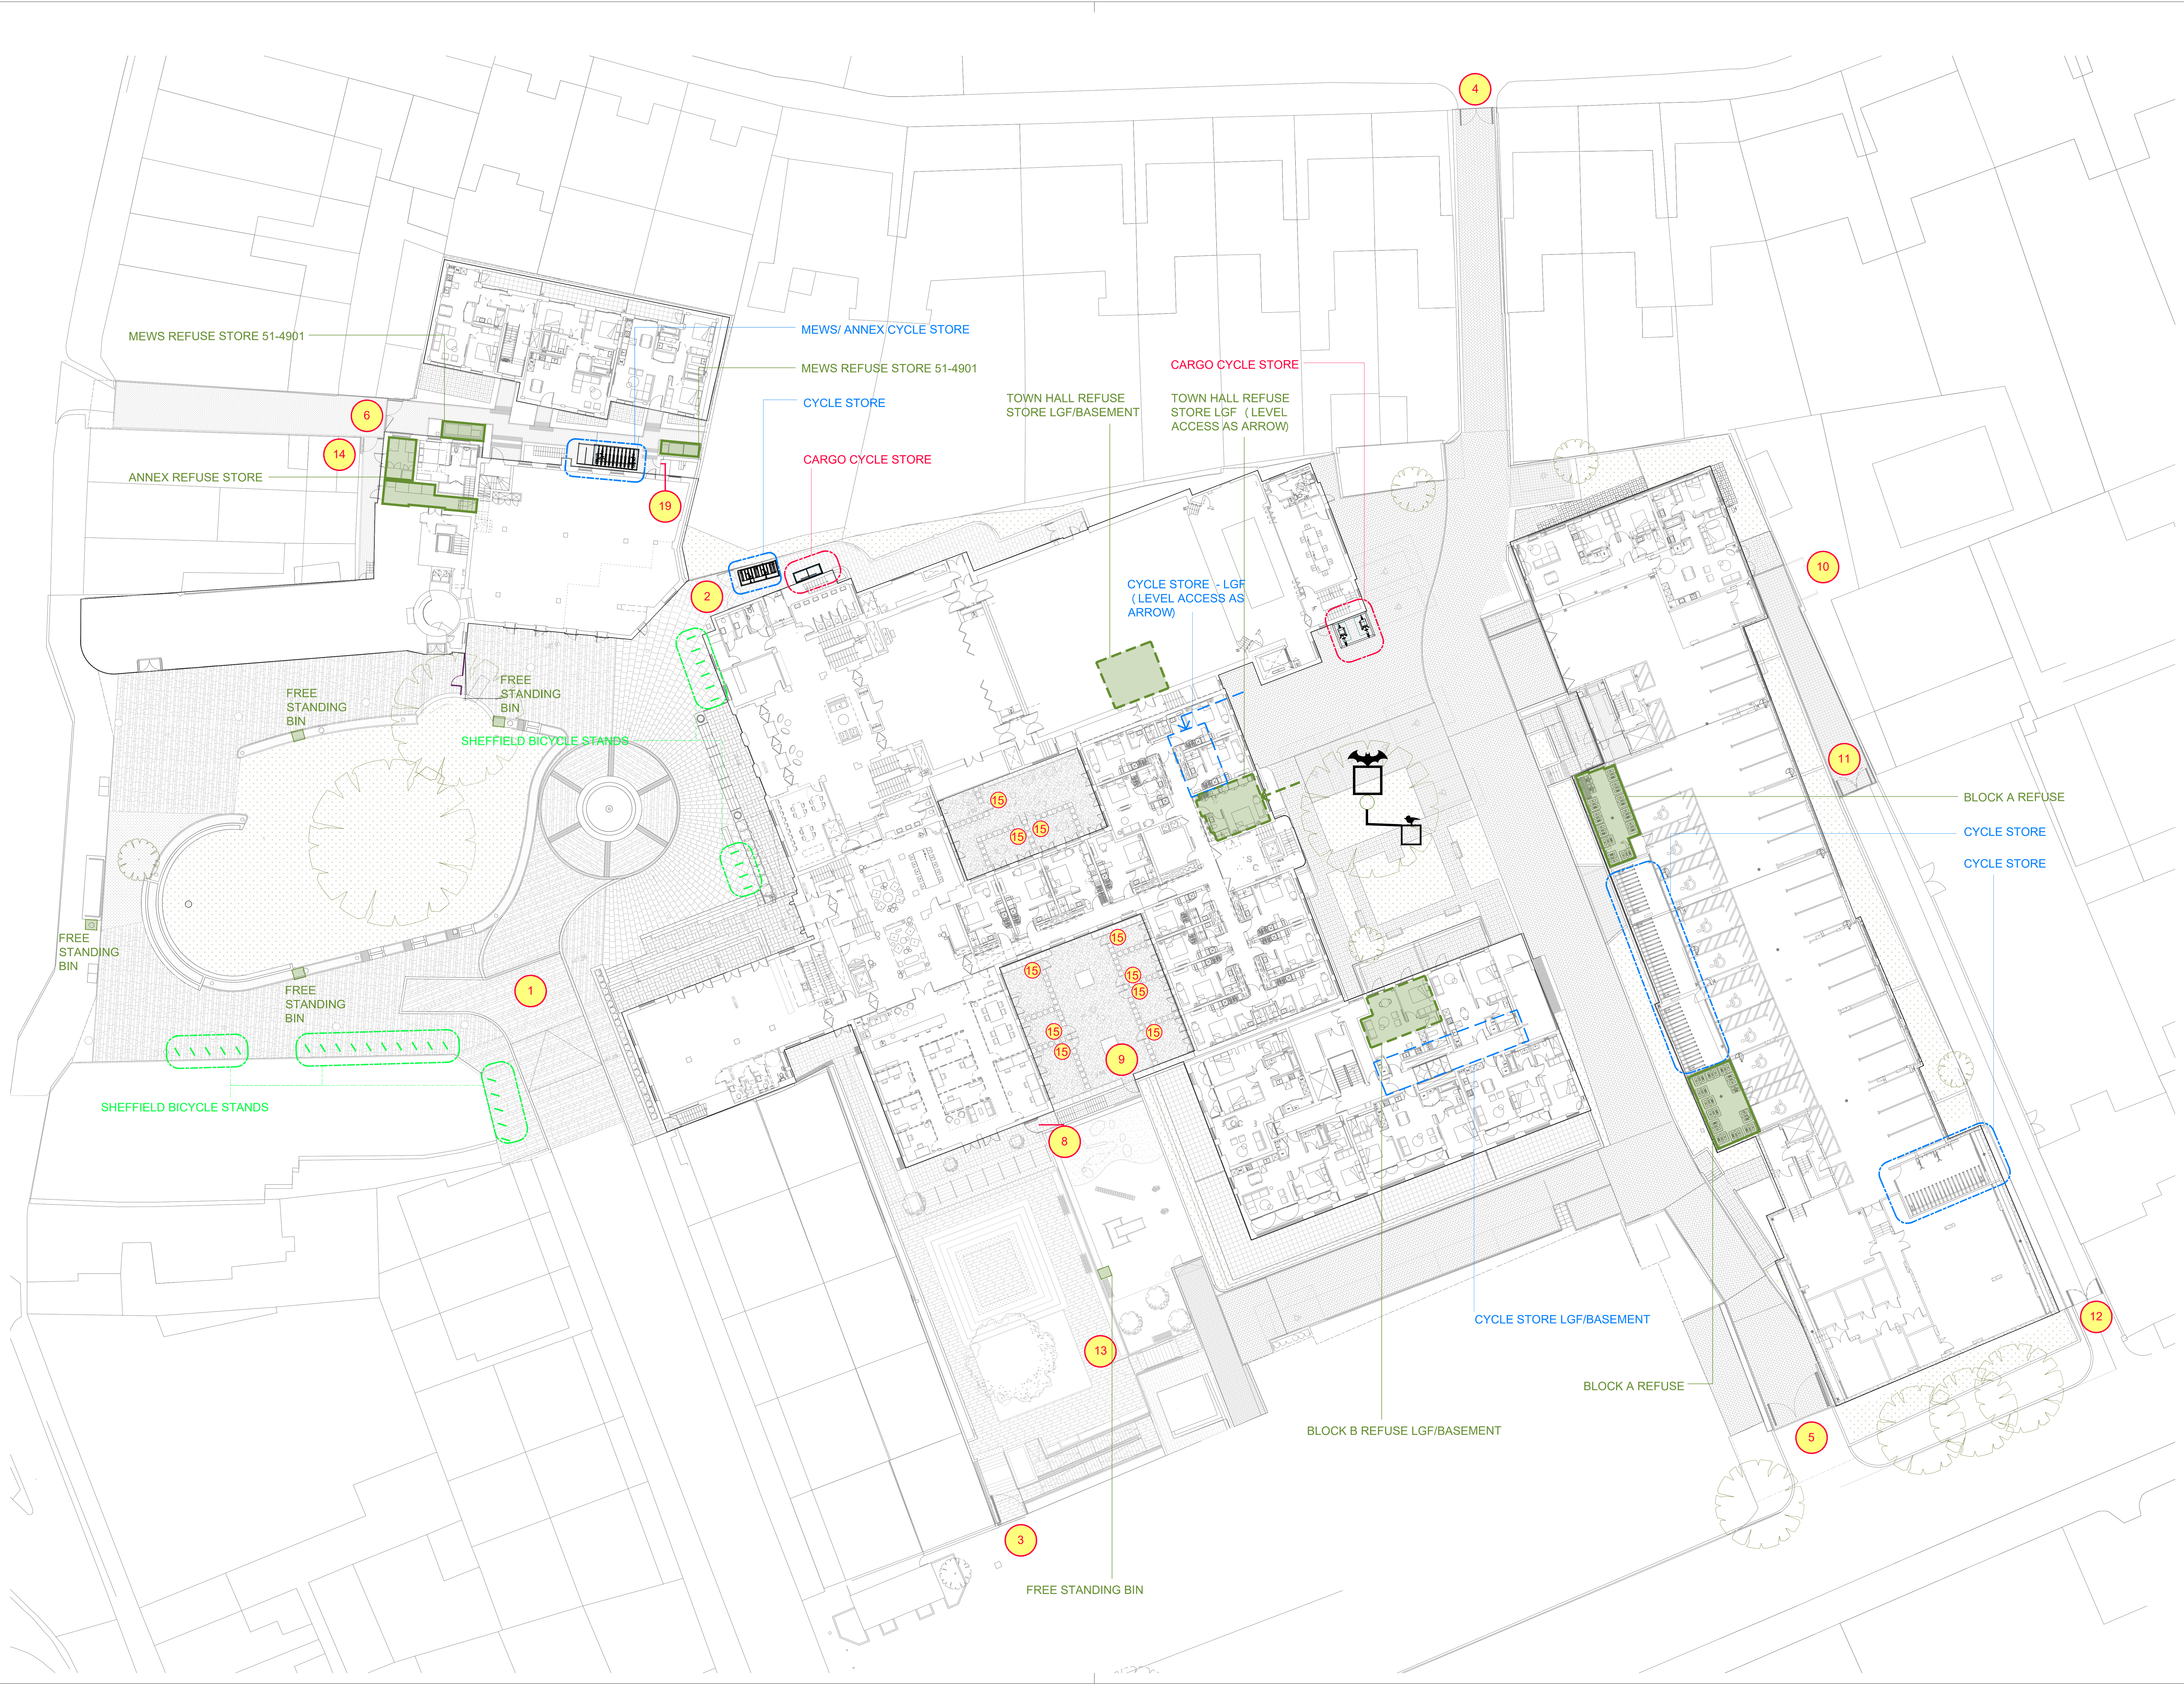

© Longlane Architects Ltd
No part of this drawing may be reproduced without written consent.
All contractors must visit this and be responsible for taking and checking all
dimensions relating to this work.
Do not scale from this drawing.

REVISION NOTES
AB 03.02.25 PS AS BUILT - FOR INFORMATION

KEY:

- REFUSE LGF/BASEMENT
- REFUSE
- BICYCLE STANDS
- CARGO CYCLE STORE
- SHORT STAY PUBLIC
- GATE NUMBERS
- BAT BOXES
- BIRD BOXES

AS BUILT

PROJECT
HORNSEY TOWN HALL

DRAWING TITLE
LANDSCAPE REFERENCE PLAN

SCALE
1:200 @ A0

DATE DRAWN BY
16.03.23

WB

3670-KDS-TH-ZZ-DR-A-90-1001