


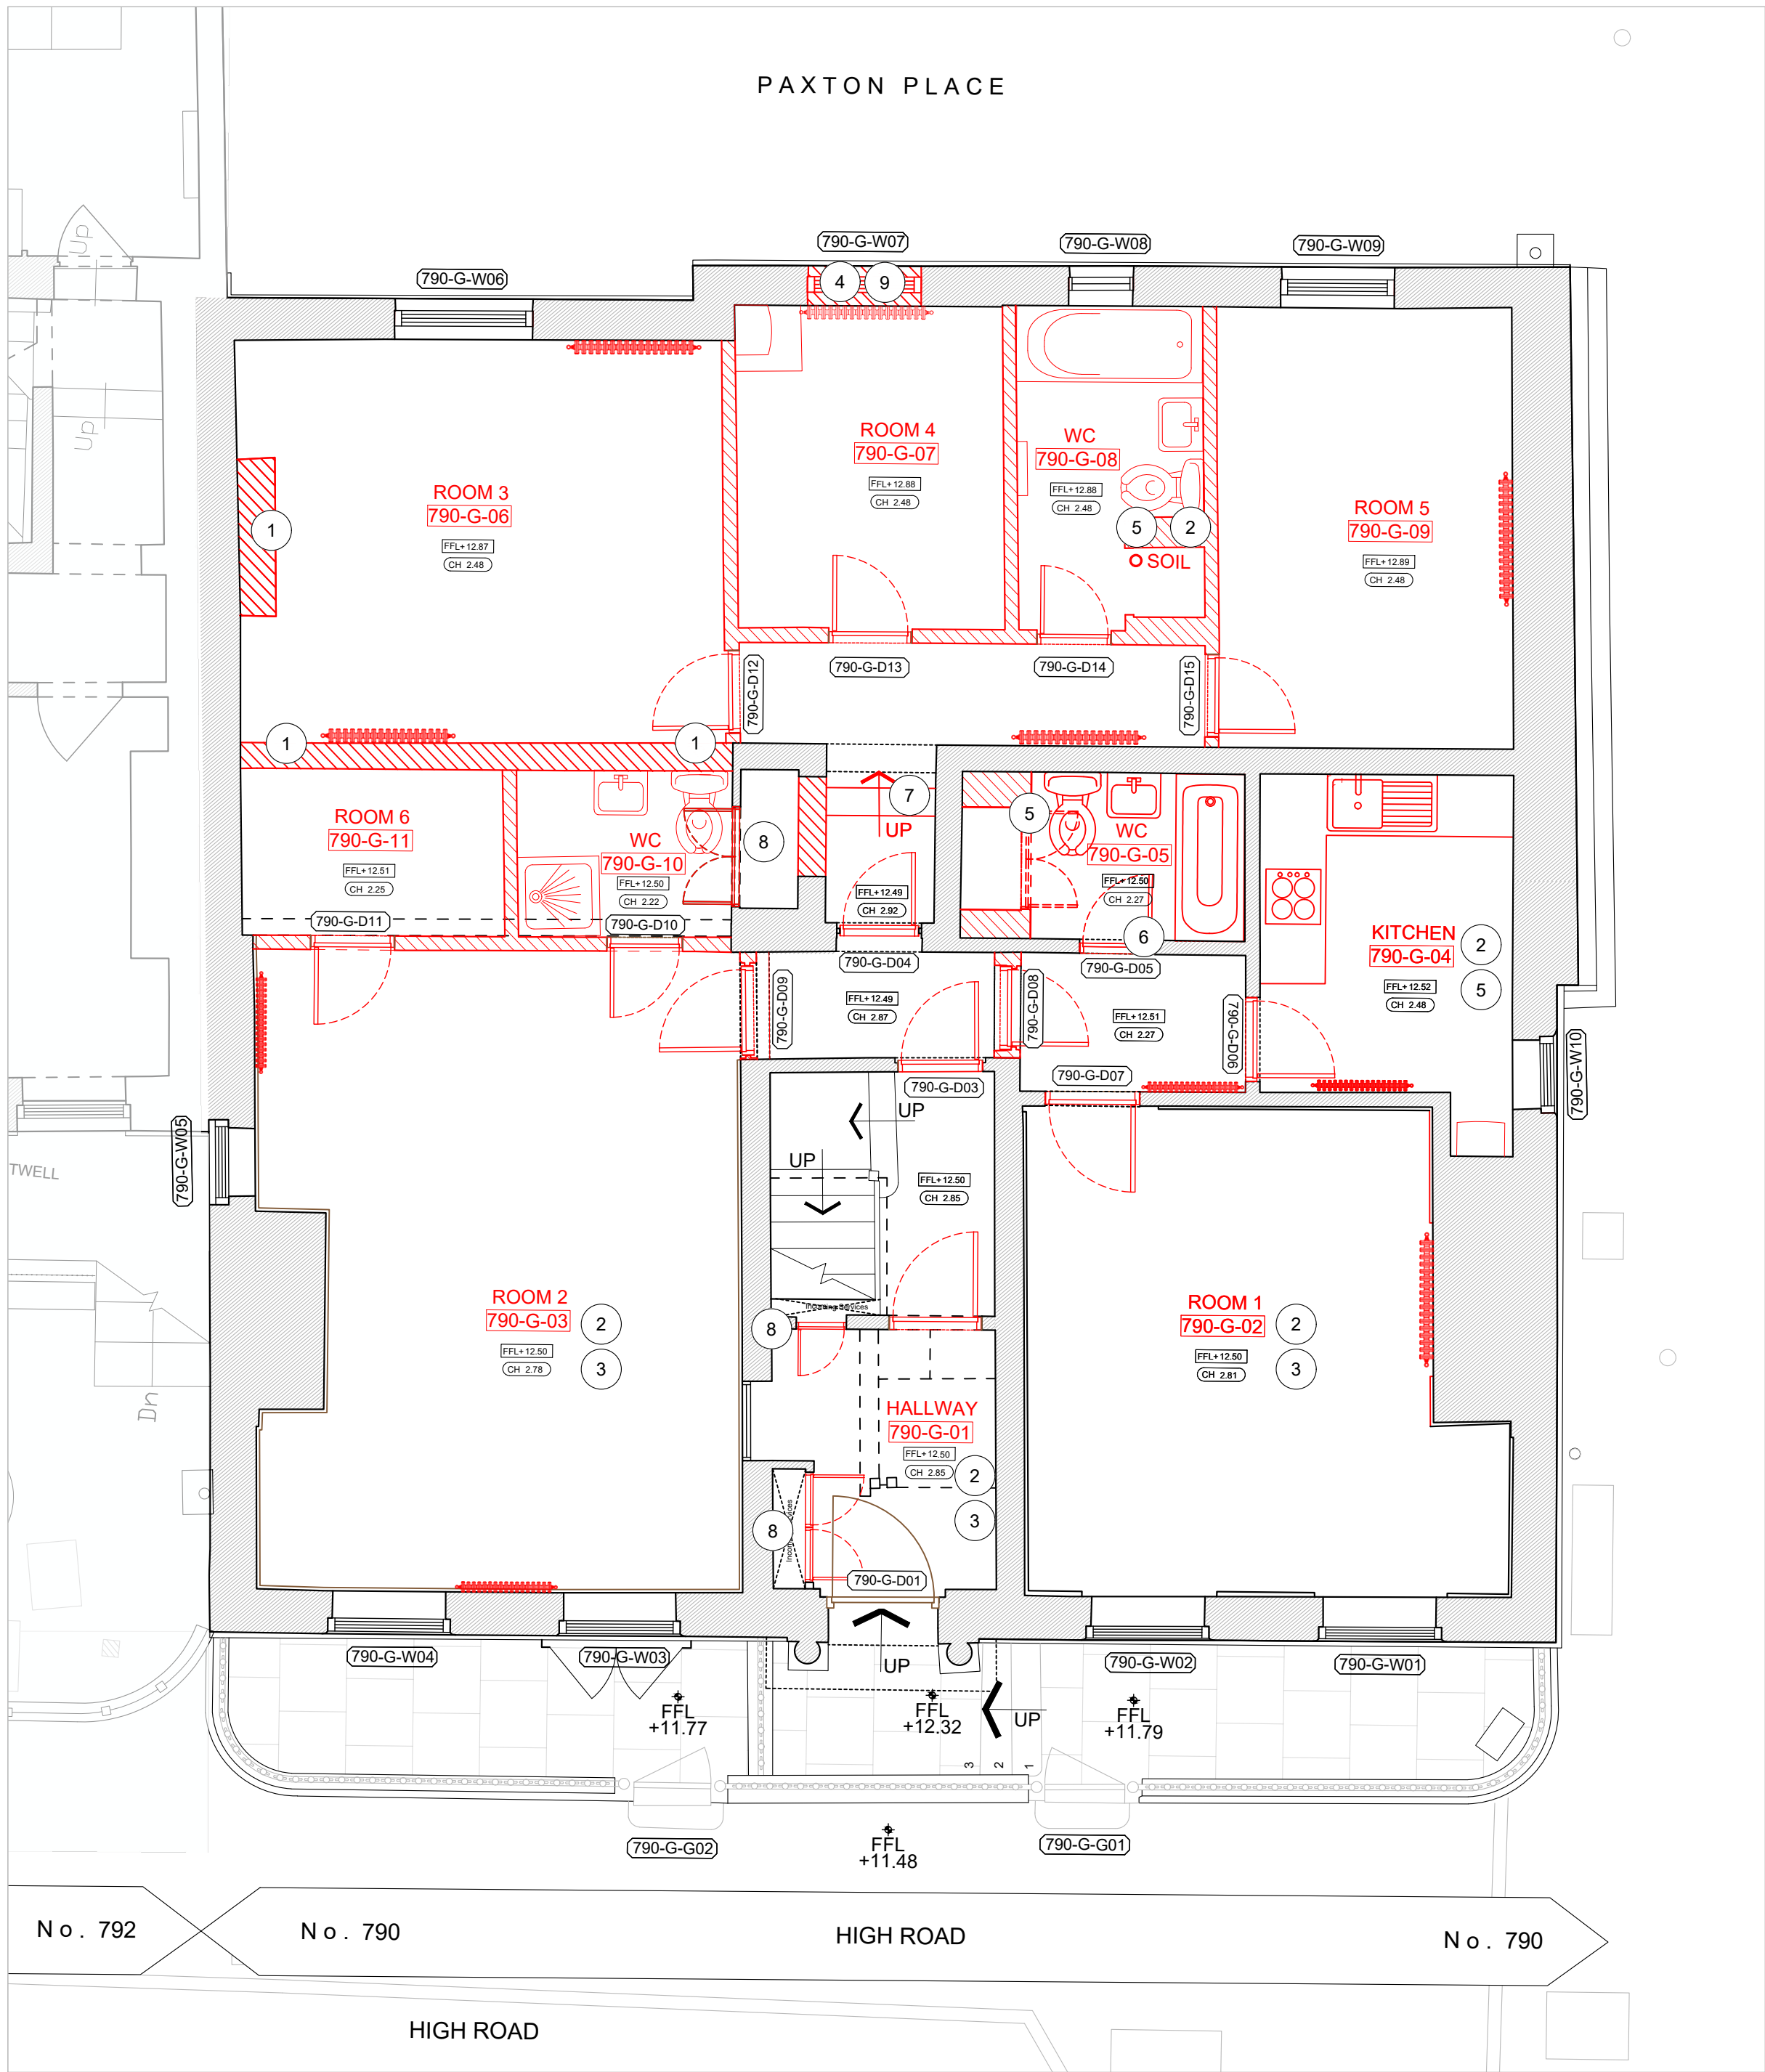


01 No. 790 EXISTING S/O GROUND FLOOR PLAN
82000 Scale 1:50

General notes:

- Protect all existing surfaces and windows adjacent work areas which are to be retained.
- Drawings to be read in conjunction with all other drawings, specifications, project documents and consultant information.
- Existing M&E shown indicatively. Carefully strip out all existing services unless stated otherwise and make good.

Strip Out notes:

1. Carefully remove modern brickwork/partition to suit proposed design. Refer to drawings for location and extent.
2. Carefully lift uneven historic floorboards where existing to assess condition of structure beneath. Allow like for like repairs. Existing boards to be documented, recorded, and set aside to store for later re-use.
3. Skirting - carefully dismantle skirting where present and set aside to store for repair and later reinstatement.
4. Allow to create opening as shown to suit proposed design.
5. Carefully strip modern services/downpipes where redundant without affecting C18th fabric.
6. Doors - carefully dismantle door, record condition, number and set aside for repair and later reinstatement.
7. Carefully strip out modern steps. Extent as shown.
8. Existing incoming services. Allow for inspection and consolidate.
9. Allow to remove window complete. Allow to remove vegetation complete including roots.
10. Strip out 1 no. step to the terrace.
11. Carefully remove modern dado without damaging historic fabric.

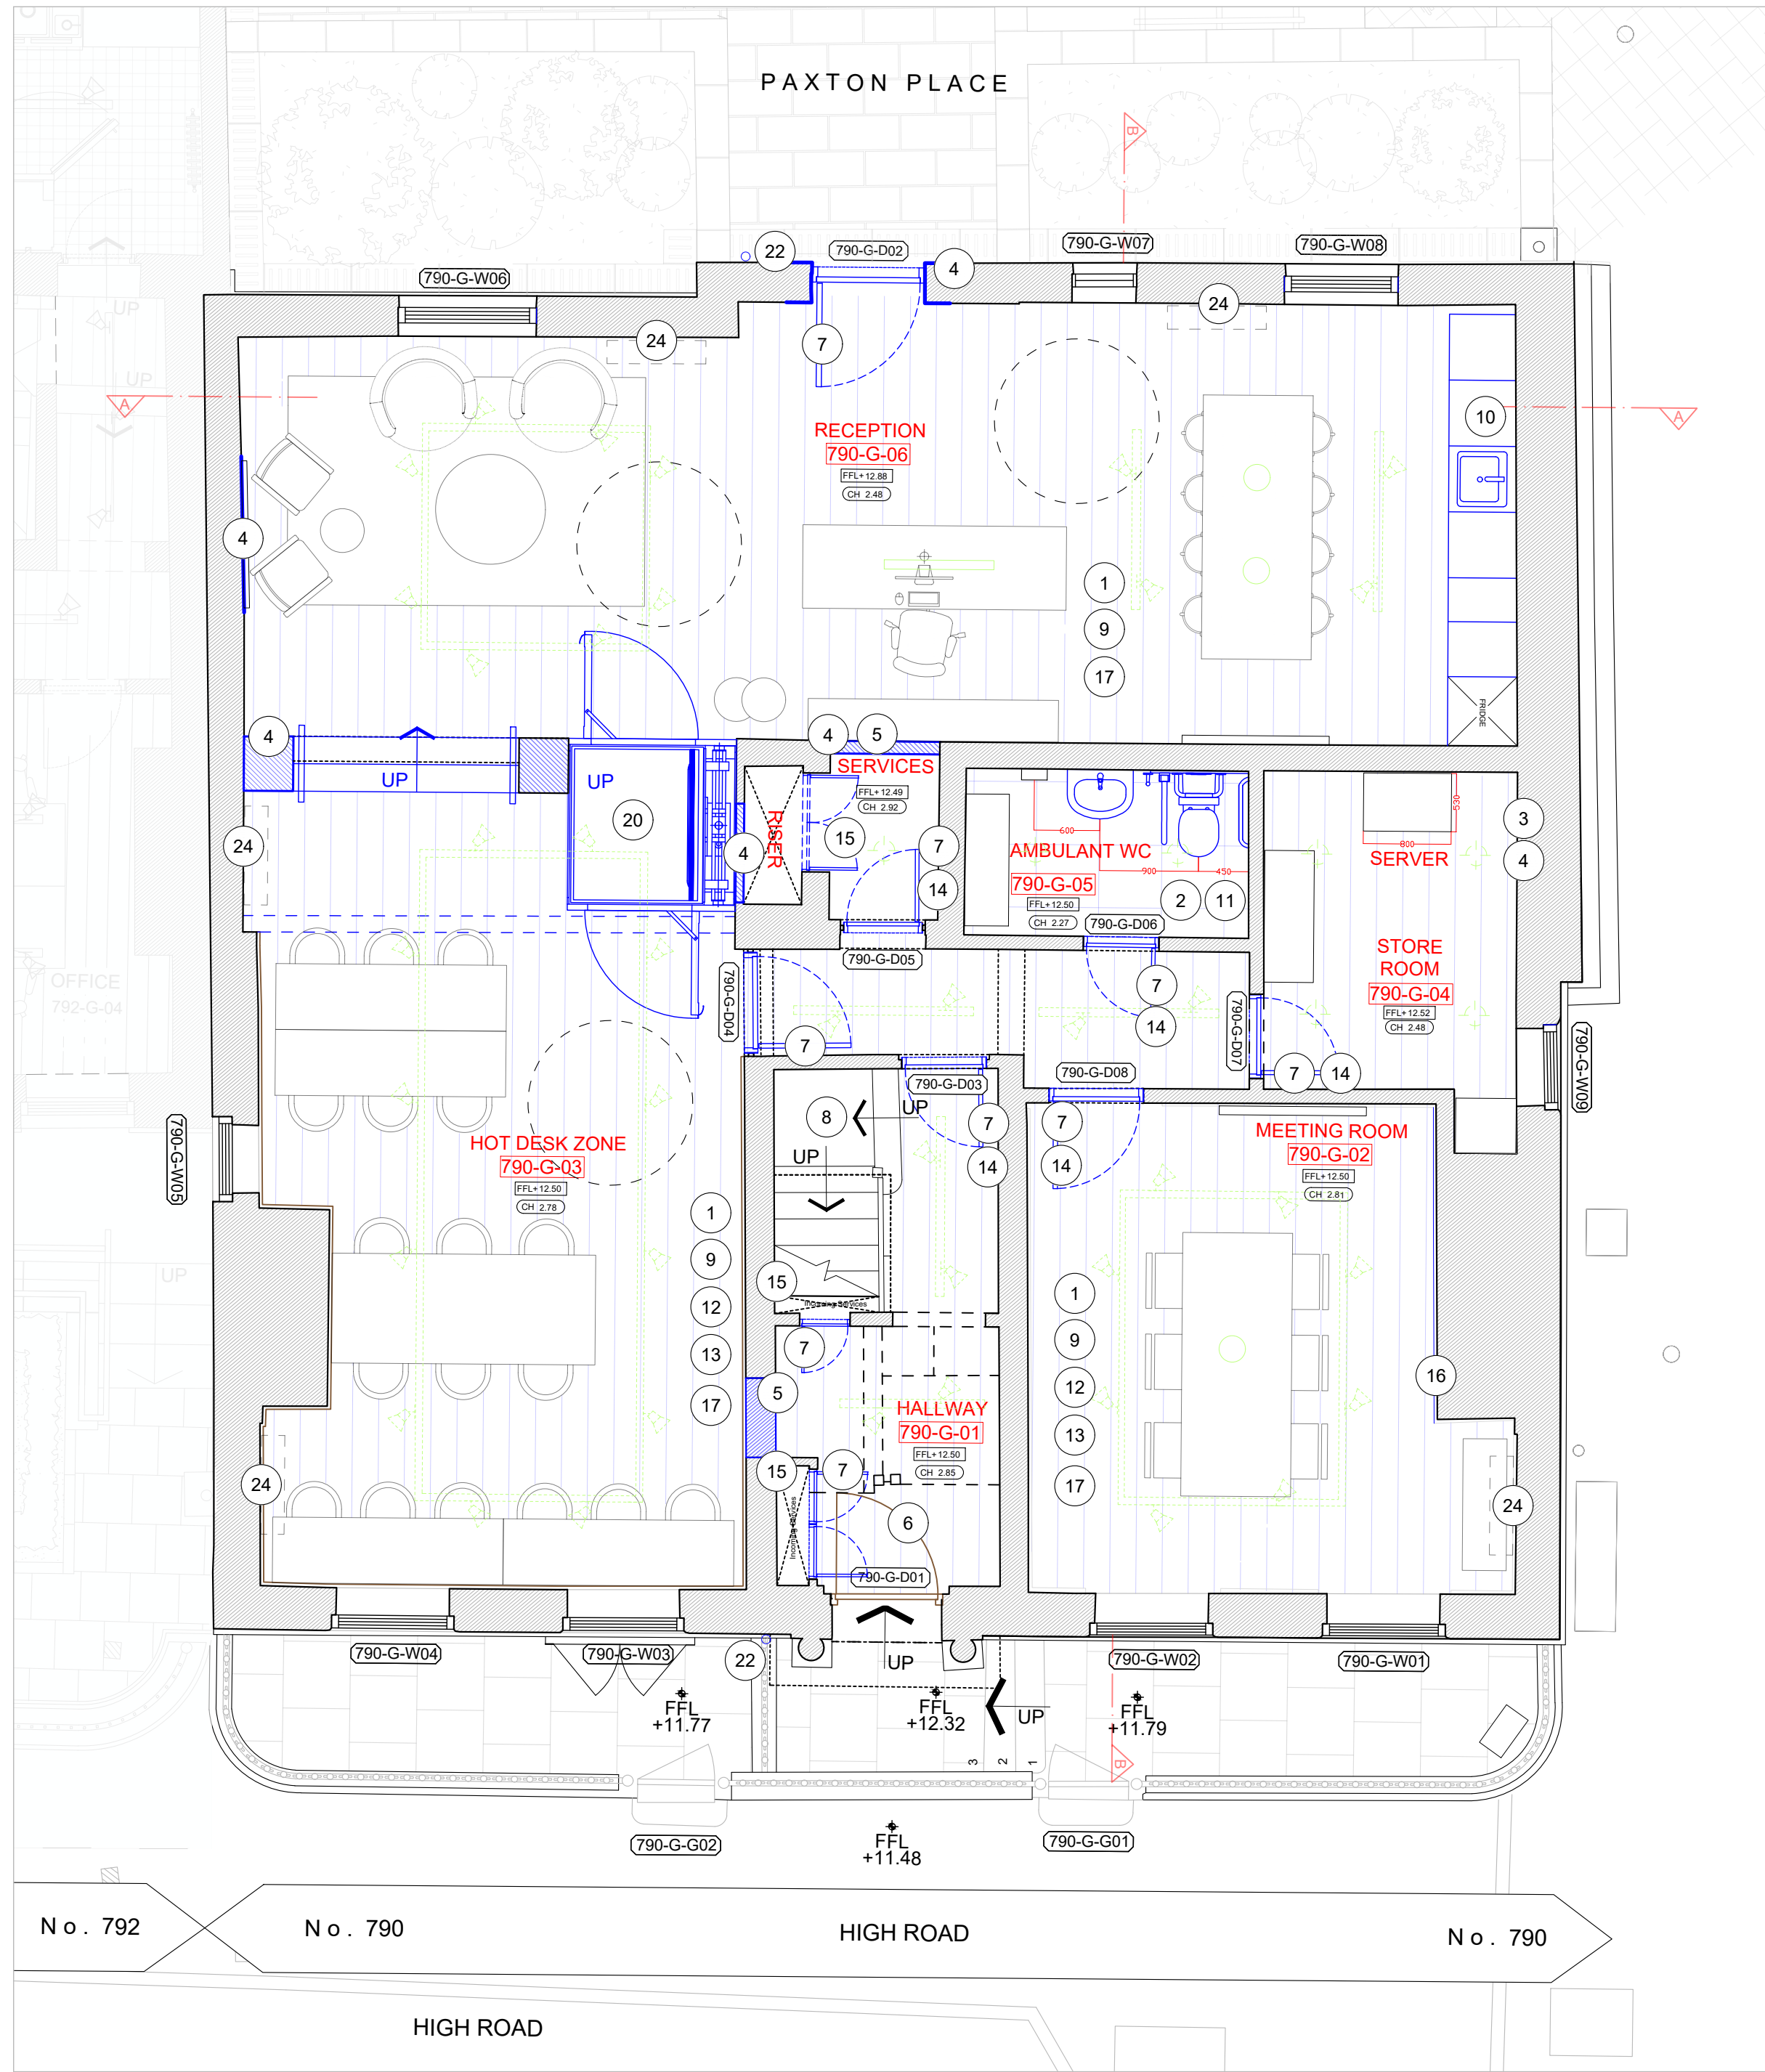

02 No. 790 PROPOSED GROUND FLOOR PLAN
82000 Scale 1:50

General notes:

- Protect all existing surfaces and windows adjacent work areas which are to be retained.
- Drawings to be read in conjunction with all other drawings, specifications, project documents and consultant information.
- Existing M&E shown indicatively. Make good fixing holes and existing fabric where services removed to match existing adjacent. Allow to provide new column radiators to MEP Engineer's detail. To be developed further.
- Carry out compartmentation work in line with the fire engineer's report. To be developed further.
- All floors to be upgraded in terms of fire performance.


Proposed notes:

1. Floor Type 1 : No historic floor boards survive. Allow for new carpet tiles/engineered timber. Refer to interior finishes for scope.
2. Floor Type 2 : New Tiles to suit proposed design.
3. Allow for new floor and associated structure to SE's detail where missing.
4. Make good opening following removal of brickwork/modern partition. Allow to infill opening as existing adjacent to suit proposed design. Scope as shown.
5. New internal partition to suit proposed design. Scope as shown.
6. Existing Door - Repair, fire rate, and renew ironmongery as necessary. Refer to door schedule for further information.
7. New Door - New door to suit proposed design.
8. Existing staircase: allow to hand scrub and clean using turpentine. Allow like for like repairs as necessary and make good.
9. Allow to redecorate existing paneling/paint/wallpaper.
10. Kitchen - Allow to install contemporary kitchen fittings without affecting the C18th fabric. Refer to proposed room elevations for further details.
11. WC - Allow to install contemporary sanitary fittings without affecting the C18th fabric. Refer to proposed room elevations for further details.

N.B: Rear Landscaping forms a part of separate Planning and Listed Building Consent Application but are shown here for completeness.
N.B: Loose furniture shown indicatively. Subject to tenant fit-out.

- KEY
- Demolition walls/modern partitions
 - Proposed walls/modern partitions
 - Demolition
 - Proposed
 - New ceiling
 - Dismantle for later reinstatement
 - Loose furniture shown indicatively

12. Skirting - Reinstall existing skirting. Repair/replace where missing or rotted.
13. Cornices - Replace sections of cornices where missing. Allow to reinstall all missing cornices to Ground and First floor to match original historic setting.
14. Architraves - Make good/replace sections of architrave where missing. Profile to match existing adjacent where present.
15. Cupboards - Repair and ease out door and ironmongery where existing. Replace where missing or rotted.
16. Dado - Allow to rebuild missing dado to match existing adjacent. Scope as shown.
17. New suspended LED track lighting or surface mounted linear/downlight as shown. To be developed further with MEP engineer.
18. Allow to rebuild new steps to roof terrace to suit Part M and K requirements.
19. Carefully clean existing paving stones. Allow to replace chipped/ cracked tiles as necessary.
20. Allow for new platform lift. Scope as shown.
21. Allow for new ceiling. Scope as shown.
22. Allow for new CCTV to install without damaging the historic fabric.
23. Allow to install new crittall glazed partition to suit proposed design. Scope as shown.
24. Allow to install new FCU. Scope as shown.

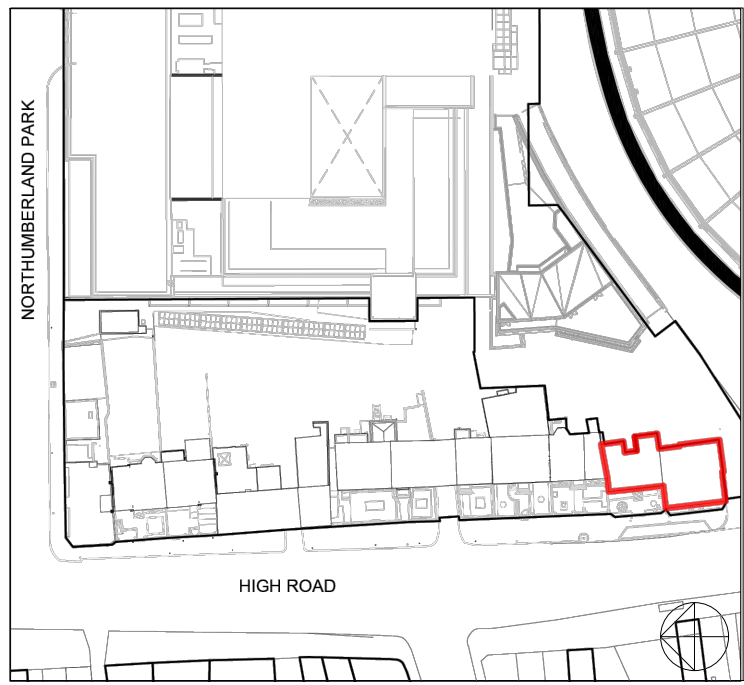

KEY PLAN

NOTES:

This drawing is copyright and owned by F3 Architects LLP and is for use on this site only unless contractually stated otherwise.
DO NOT SCALE this drawing (printed or electronic versions). Contractors must check all dimensions on site.
All other design team elements, where indicated have been imported from the consultant's drawings and reference should be made to the individual consultant's drawings for exact setting out, size and type of component.
Discrepancies and / or ambiguities within this drawing, between it and information given elsewhere, must be reported immediately to the architect for clarification before proceeding.
All works are to be carried out in accordance with the latest British Standards and Codes of Practice unless specifically directed in the specification.
Responsibility for the reproduction of this drawing in any format, lies with the recipient to check that all information has been replicated in full and is correct when compared to the original paper or electronic image. Graphical representations of equipment on this drawing are approximations only. Please refer to specifications and / or details for actual sizes and / or specific contractor construction information.
This original document is issued for the purpose indicated in the title block and contains information of a confidential nature. Further copies and circulation will be strictly in accordance with the confidentiality agreement under the contract. This original must be destroyed or returned to the originator.
Levels shown have been interpolated from drawn information received from a third party and F3 Architects do not warrant the accuracy of that information. It is the responsibility of the Main Contractor to check all information contained within this drawing prior to work being carried out. Any discrepancies or ambiguities within this drawing, between it and the existing site, must be reported immediately to the Design Team before proceeding. The boundary redline shown is indicative.
Except for Planning purposes, figured dimensions only are to be taken from this drawing. All dimensions are in millimetres unless otherwise stated.
All dimensions shall be checked on site prior to works commencing.
Any discrepancies shall be reported to the Architect.
© Copyright F3 Architects. All rights reserved.

SAFETY, HEALTH AND ENVIRONMENTAL INFORMATION

It is assumed that all works on this drawing will be carried out by a competent contractor, working where appropriate to an approved method statement.

DATE	AH	FOR PLANNING & LBC	S.2	P1
28.11.2024	CHK	DESCRIPTION	STA	NO.

REVISION HISTORY



A: 5 Rochester Mews - London - NW1 9JB
T: 020 7267 6332
W: f3architects.com
E: info@f3architects.com

Health and Safety

Refer to relevant Construction (Design and Management) documentation where applicable. The Contractor shall plan, manage and monitor the works inclusive of temporary erection stability. Any works that are found to be unstable in the temporary state are to be reported directly to the structural engineer and Main Contractor/ Package Manager in order to provide safe temporary support. Check on site prior to commencement of works/fabrication etc.

Project
NO. 790 HIGH ROAD - DIAL HOUSE
NO. 790 HIGH ROAD
LONDON
N17 0BX

Title
STRIP OUT + PROPOSED GROUND FLOOR PLAN

Drawn By Scale Paper Project No.
LJ 1 : 50 A1 220329

Status Revision
STAGE 3 - PLANNING & LBC S2.P1

Drawing no
NTDH-F3A-ZZ-00-GA-A-82000

